


Give All Information Completely
Make Required Affidavit
Mail or Deliver Report to:
Conservation Division
State Corporation Commission
800 Bitting Building
Wichita, Kansas

WELL PLUGGING RECORD

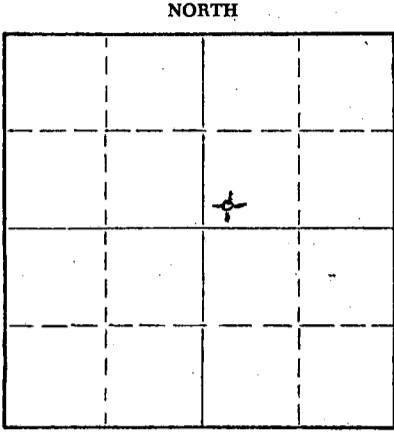

Locate well correctly on above Section Plat

Graham County, Sec. 16 Twp. 9S Rge. 22 (E) W (W)
Location as "NE/CNWxSWx" or footage from lines SW SW NE
Lease Owner Peel-Hardman Oil Producers
Lease Name Walker Well No. 2
Office Address P.O. Box 359, Hoisington, Kansas
Character of Well (completed as Oil, Gas or Dry Hole) Dry hole
Date well completed Dec. 9, 1954
Application for plugging filed Dec. 9, 1954
Application for plugging approved Dec. 9, 1954
Plugging commenced Dec. 9, 1954
Plugging completed Dec. 10, 1954
Reason for abandonment of well or producing formation Dry hole

If a producing well is abandoned, date of last production 19
Was permission obtained from the Conservation Division or its agents before plugging was commenced? Yes

Name of Conservation Agent who supervised plugging of this well Eldon Petty
Producing formation _____ Depth to top _____ Bottom _____ Total Depth of Well 3970 Feet
Show depth and thickness of all water, oil and gas formations.

OIL, GAS OR WATER RECORDS

CASING RECORD

FORMATION	CONTENT	FROM	TO	SIZE	PUT IN	PULLED OUT
		0	158	8 5/8"	158'	None

Describe in detail the manner in which the well was plugged, indicating where the mud fluid was placed and the method or methods used in introducing it into the hole. If cement or other plugs were used, state the character of same and depth placed, from _____ feet to _____ feet for each plug set.

From 3970 to 156 1/2' - heavy rotary mud
156 1/2' to 155' - wooden plug
155' to 109' - 15 sacks cement and 1/2 sack hulls
109' to 41 1/2' - heavy rotary mud
41 1/2' to 40' - wooden plug
40' to 6' - 10 sacks cement and 1/2 sack hulls
6' to surface - cellar

7 10 17
COMMISSION


CONSERVATION DIVISION
Wichita, Kansas

(If additional description is necessary, use BACK of this sheet)
Name of Plugging Contractor Glenn W. Peel
Address P.O. Box 359, Hoisington, Kansas

12-15-54

STATE OF KANSAS, COUNTY OF BARTON, ss.
Glenn W. Peel (employee of owner) or (owner or operator) of the above-described well, being first duly sworn on oath, says: That I have knowledge of the facts, statements, and matters herein contained and the log of the above-described well as filed and that the same are true and correct. So help me God. GLENN W. PEEL

BY: *Glenn W. Peel*
(Signature) P.O. Box 359, Hoisington, Kansas
(Address)

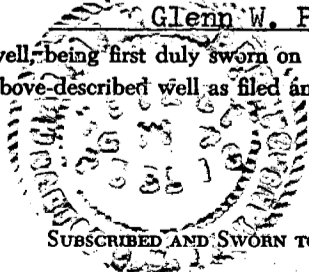

SUBSCRIBED AND SWORN TO before me this 14th day of December, 1954

Marian M. Herbert
Notary Public.

My commission expires June 4, 1955

PLUGGING
FILE SEC 16 T 9 R 22W
BOOK PAGE 83 LINE 31

15-065-0039700-00

DRILLERS' LOG

Company: Peel-Hardman Oil Producers

SW SW NE

Farm Name: Walker Well No. 2

Sec. 16, Twp 9S, Rge. 22W,

Total Depth: 3970'

County: Graham,
Kansas

Comm: 11-30-54 Comp: 12-10-54
Contractor: Glenn W. Peel

Elevation:

Casing: 8 5/8" 158' Cem.

Production: Dry

Figures below indicate bottoms of formations:

Sand	-0-	20
Rock		40
Shale		900
Sand and shale		1590
Shale		1850
Anhydrite		2180
Shale and Lime		2555
Lime		3070
Lime and shale		3305
Lime		3970
Total Depth		3970

This is to certify that the above information is to the best of our knowledge, true and correct.

GLENN W. PEEL

BY: *Glenn W. Peel*

SUBSCRIBED AND SWORN to before me this 14th day of December, 1954.

My commission expires: June 4, 1955

Marion M. Herbert
Notary Public



RECEIVED
STATE COMMISSION
JAN 27 1955
CONSERVATION DIVISION
Wichita, Kansas
1-27-55

PLUGGING
FILE SEC 16 T 9 R 22W
BOOK PAGE 84 LINE 16