


Give All Information Completely
Make Required Affidavit
Mail or Deliver Report to:
Conservation Division
State Corporation Commission
211 No. Broadway
Wichita, Kansas

WELL PLUGGING RECORD

NORTH

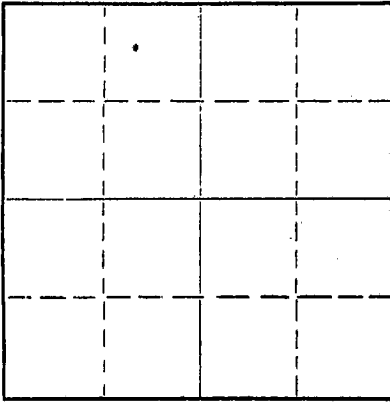

Locate well correctly on above
Section Plat

Graham County, Sec. 19 Twp. 9S Rge. 22W (E) (W)
Location as "NE/CNWxSWx" or footage from lines C SW SW
Lease Owner Leben Drilling, Inc.
Lease Name Sullivan Well No. 1
Office Address Box 486, Great Bend, Kansas 67530
Character of Well (completed as Oil, Gas or Dry Hole) Dry Hole
Date well completed 1-2-65 19
Application for plugging filed 1-2-65 19
Application for plugging approved 1-2-65 19
Plugging commenced 1-2-65 19
Plugging completed 1-2-65 19
Reason for abandonment of well or producing formation Dry Hole

If a producing well is abandoned, date of last production 19
Was permission obtained from the Conservation Division or its agents before plugging was commenced? yes

Name of Conservation Agent who supervised plugging of this well W. L. Nichols, Moreland, Kansas
Producing formation _____ Depth to top _____ Bottom _____ Total Depth of Well 3910 Feet
Show depth and thickness of all water, oil and gas formations.

OIL, GAS OR WATER RECORDS

CASING RECORD

FORMATION	CONTENT	FROM	TO	SIZE	PUT IN	PULLED OUT
				8 5/8"	213'	none

Describe in detail the manner in which the well was plugged, indicating where the mud fluid was placed and the method or methods used in introducing it into the hole. If cement or other plugs were used, state the character of same and depth placed, from _____ feet to _____ feet for each plug set.

Plug @ 540' with 20 sacks cement
Plug @ 210' with 1/3 sk. hulls 20 sacks cement
Plug bridged with 1/2 sk. hulls 10 sacks cement to cellar bottom

RECEIVED
STATE CORPORATION COMMISSION

JAN 8 1965

CONSERVATION DIVISION
Wichita, Kansas

1-8-65

(If additional description is necessary, use BACK of this sheet)

Name of Plugging Contractor Leben Drilling, Inc.
Address Box 486, Great Bend, Kansas

STATE OF KANSAS, COUNTY OF BARTON, ss.

Leslie Kite (employee of owner) or (owner or operator) of the above-described well, being first duly sworn on oath, says: That I have knowledge of the facts, statements, and matters herein contained and the log of the above-described well as filed and that the same are true and correct. So help me God.

(Signature)

Leslie Kite

P. O. Box 486, Great Bend, Kansas
(Address)

SUBSCRIBED AND SWORN TO before me this 7th day of January, 1965

Wladimir Nichols
Notary Public.

My commission expires April 1, 1967

DRILLER'S LOG

COMPANY: Leben Drilling, Inc.
 CONTRACTOR: LEBEN DRILLING, INC.
 FARM: SULLIVAN #1
 LOCATION: C SW SW Sec. 19-9S-22W
 GRAHAM COUNTY, KANSAS
 COMMENCED: 12-23-64
 COMPLETED: 1-2-65

0	160	Shale & Sand
160	935	Shale
935	1465	Shale & Shells
1465	1949	Sand & Shale
1949	1986	Anhydrite
1986	2050	Shale & Shells
2050	2510	Shale
2510	2645	Shale & Lime
2645	3400	Lime & Shale
3400	3580	Shale & Lime
3580	3910	Lime
	<u>3910</u>	<u>Rotary Total Depth</u> - D. & A.

RECEIVED
 STATE CORPORATION COMMISSION
 JAN 8 1965
 1-8-65
 CONSERVATION DIVISION
 Wichita, Kansas

Set 8 5/8" used surface casing @ 213' with 165 sacks 60-40 Posmix
 Sunset

I, Leslie Kite, do hereby certify that the above and foregoing is a true and correct copy of the driller's log regarding the Sullivan #1 well, located C SW SW of Section 19, Township 9 South, Range 22 West, Graham County, Kansas, as reflected by the files of Leben Drilling, Inc.

Leslie Kite
 Leslie Kite

STATE OF KANSAS)
) SS
 COUNTY OF BARTON)

Subscribed and sworn to before me, a Notary Public, in and for Barton County, Kansas, this 7th day of January, 1965.

Ulanda Nichols
 Ulanda Nichols

