


15-065-21430-00.00

STATE OF KANSAS  
STATE CORPORATION COMMISSION

WELL PLUGGING RECORD

Give All Information Completely  
Make Required Affidavit  
Mail or Deliver Report to  
Conservation Division  
State Corporation Comm.  
245 North Water  
Wichita, KS 67202

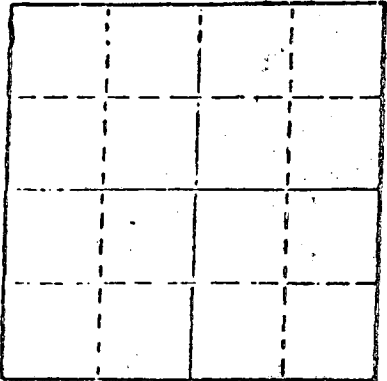

Graham County, Sec. 21 Twp. 9S Rge. 22 E1/4  
Location as "NE/CNW1/4SW1/4" or footage from lines  
SE SE NW  
Lease Owner Sandlin Oil Corporation  
Lease Name Sandlin Well No. 1  
Office Address 2300 Security Life Bldg., Denver, CO 80202  
Character of Well (Completed as Oil, Gas or Dry Hole)  
Dry Hole  
Date Well completed 7-7 1981  
Application for plugging filed 7-7 1981  
Application for plugging approved 7-7 1981  
Plugging commenced 7-8 1981  
Plugging completed 7-8 1981  
Reason for abandonment of well or producing formation  
Dry Hole  
If a producing well is abandoned, date of last production 19

Was permission obtained from the Conservation Division or its agents before plugging was commenced? yes  
Name of Conservation Agent who supervised plugging of this well Gil Balthazor  
Producing formation Depth to top Bottom Total Depth of Well  
Show depth and thickness of all water, oil and gas formations.

OIL, GAS OR WATER RECORDS

CASING RECORD

FORMATION	CONTENT	FROM	TO	SIZE	PUT IN	PULLED OUT
				8-5/8"	262'	-0-

Describe in detail the manner in which the well was plugged, indicating where the mud fluid was placed and the method or methods used in introducing it into the hold. If cement or other plugs were used, state the character of same and depth placed, from feet to feet for each plug set.

Mud laden fluid 4080' - 1000'  
60 sks cement @ 1000'  
30 sks cement @ 280'  
40 sks cement @ 10'  
5 sks cement in rat hole.

(If additional description is necessary, use BACK of this sheet)

Name of Plugging Contractor Emphasis Oil Operations


STATE OF KANSAS COUNTY OF RUSSELL, ss.  
Joe K. Branum (employee of owner) or (owner or operator)  
of the above-described well, being first duly sworn on oath, says: That I have knowledge of the facts, statements, and matters herein contained and the log of the above-described well as filed and that the same are true and correct. So help me God.

(Signature) Joe K. Branum  
P. O. Box 506, Russell, KS 67665  
(Address)

SUBSCRIBED AND SWORN TO before me this 14th day of July, 1981.

My commission expires February 6, 1984.

Glenda R. Tiffin Notary Public.

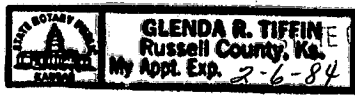

RECEIVED  
CORPORATION COMMISSION  
7-15-81  
JUL 15 1981

15-065-21430-00-00

EMPHASIS OIL OPERATIONS

P. O. Box 506

Russell, Kansas 67665

DRILLERS LOG

OPERATOR: Sandlin Oil Corporation  
2300 Security Life Building  
Denver, Colorado 80202

CONTRACTOR: Emphasis Oil Operations  
P. O. Box 506  
Russell, Kansas 67665

LEASE: Sandlin WELL: #1

LOCATION: SE SE NW  
Section 21-9S-22W  
Graham County, Kansas

Total Depth: 4080'

Elevation:

Commenced: 6-30-81

Completed: 7-8-81

Casing: 8-5/8" @ 262' with 175 sks cement

Status: Dry Hole

DEPTHS & FORMATIONS

(All measurements from K.B.)

Topsoil & Sand	40'	Shale	3260'
Sand & Shale	1664'	Shale & Lime	3625'
Shale	1883'	Lime	3699'
Anhydrite	1936'	Shale & Lime (R.T.D.)	4080'

RECEIVED  
STATE CORPORATION COMMISSION  
JUL 15 1981  
7-15-81  
CONSERVATION DIVISION  
Wichita, Kansas

STATE OF KANSAS )  
                          ) ss:  
COUNTY OF RUSSELL)

I, Joe K. Branum, of Emphasis Oil Operations, state that the above and foregoing is a true and correct log of the above captioned well.

*Joe K. Branum*  
\_\_\_\_\_  
Joe K. Branum

Subscribed and sworn to before me this 14th day of July, 1981.

My Commission Expires: February 6, 1984.



*Glenda R. Tiffin*  
\_\_\_\_\_  
Notary Public