

19-065-30371-00-00

STATE OF KANSAS
STATE CORPORATION COMMISSION

Form CP-4

Give All Information Completely
Make Required Affidavit
Mail or Deliver Report to:
Conservation Division
State Corporation Commission
212 No. Market
Wichita, Kansas

WELL PLUGGING RECORD

Graham County, Sec. 22 Twp. 9S Rge. (E) 22 (W)

Location as "NE/CNW%SW%" or footage from lines 150' W of C SW SE

Lease Owner Rains & Williamson Oil Co.

Lease Name Teall Well No. 1

Office Address 1425 Wichita Plaza Bldg., Wichita, Kansas

Character of Well (completed as Oil, Gas or Dry Hole) Dry Hole

Date well completed 11-19 1966

Application for plugging filed 11-19 1966

Application for plugging approved 11-19 1966

Plugging commenced 11-19 1966


Plugging completed 11-19 1966

Reason for abandonment of well or producing formation no oil or gas found
in commercial quantities

If a producing well is abandoned, date of last production 19

Was permission obtained from the Conservation Division or its agents before plugging was commenced? yes

NORTH

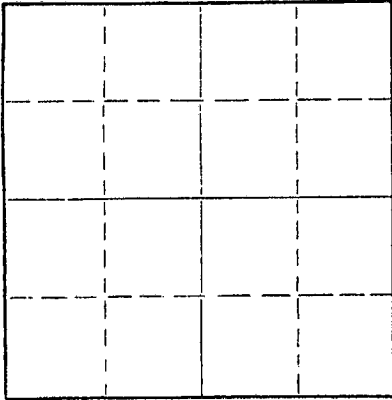

Locate well correctly on above
Section Plat

Name of Conservation Agent who supervised plugging of this well Bill Nichols, Morland, Kansas

Producing formation _____ Depth to top _____ Bottom _____ Total Depth of Well 3580 Feet

Show depth and thickness of all water, oil and gas formations.

OIL, GAS OR WATER RECORDS

CASING RECORD

FORMATION	CONTENT	FROM	TO	SIZE	PUT IN	PULLED OUT
				8-5/8"	278'	

Describe in detail the manner in which the well was plugged, indicating where the mud fluid was placed and the method or methods used in introducing it into the hole. If cement or other plugs were used, state the character of same and depth placed, from _____ feet to _____ feet for each plug set.

Pushed plug to 540'. Cemented through drill pipe with 20 sacks. Mud back to 270'. Pushed plug and cemented through drill pipe with 20 sacks. Mud back to 40' and set solid bridge. Capped with 10 sacks. Plug down 10:15 A.M.

RECEIVED
STATE CORPORATION COMMISSION

NOV 28 1966

11-28-66
CONSERVATION DIVISION
Wichita, Kansas

(If additional description is necessary, use BACK of this sheet)

Name of Plugging Contractor Rains & Williamson Oil Co.

Address 1425 Wichita Plaza Bldg., Wichita, Kansas

STATE OF Kansas, COUNTY OF Sedgwick, ss.

Wilson Rains (employee of owner) or (owner or operator) of the above-described

well, being first duly sworn on oath, says: That I have knowledge of the facts, statements, and matters herein contained and the log of the above-described well as filed and that the same are true and correct. So help me God.

(Signature) Wilson Rains


1425 Wichita Plaza Bldg., Wichita, Kansas

(Address)

Subscribed and sworn to before me this 23rd day of November, 1966

Mary J. Brown
Mary J. Brown Notary Public.

My commission expires 3-3-70

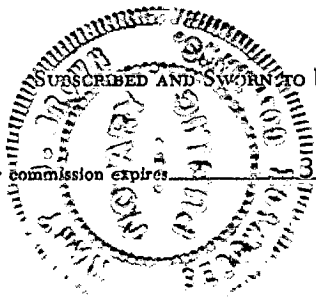

15-065-30371-00-00

ROTARY DRILLING LOG

Operator: Rains & Williamson Oil Co.,
Teall #1
150'W. of C SW SE
Section 22-9S-22W
Graham County, Kansas

Contractor: Rains & Williamson Oil Co.
Commenced: 11-14-66
Completed: 11-19-66
Remarks: Set 278' of new 8-5/8" surface
pipe with 165 sacks GL-3.

FORMATIONS:

Surface Clay	40°
Shale & Sand	194°
Shale	1370°
D. Sand	1590°
Shale & Red Bed	1705°
Shale	1862°
Anhydrite	1907°
Red Bed-Shale	2075°
Shale	2420°
Lime & Shale	2600°
Lime w/Shale	2770°
Lime & Shale	3062°
Lime w/Shale	3235°
Lime & Shale	3580°
Rotary Total Depth (D&A)	3580°

RECEIVED
STATE CORPORATION COMMISSION
NOV 28 1966
11-28-66
CONSERVATION DIVISION
Wichita, Kansas

We certify the above log is true
and correct to the best of our
knowledge and belief.

RAINS & WILLIAMSON OIL CO.
Wilson Rains
Wilson Rains

Subscribed and sworn to before me, a Notary Public in and for the State of
Kansas, County of Sedgwick, this 23rd day of November 1966.

My Commission Expires:
3-3-70

Mary J. Brown
Mary J. Brown, Notary Public

