

15-065-00292-00-00


WELL PLUGGING RECORD

Give All Information Completely
Make Required Affidavit
Mail or Deliver Report to:
Conservation Division
State Corporation Commission
800 Biting Building
Wichita, Kansas

Graham County, Sec. 25 Twp. 9S Rge. (E) 22 (W)

Location as "NE/CNW%SW%" or footage from lines SW SW SE
Lease Owner Peel-Hardman Oil Producers
Lease Name Gustafson "B" Well No. 1
Office Address P.O. Box 359, Hoisington, Kansas
Character of Well (completed as Oil, Gas or Dry Hole)
Date well completed 12-5- 19 52
Application for plugging filed 1-9- 19 53
Application for plugging approved 1-9- 19 53
Plugging commenced 4-28- 19 53
Plugging completed 5-7- 19 53
Reason for abandonment of well or producing formation Dry Hole

NORTH

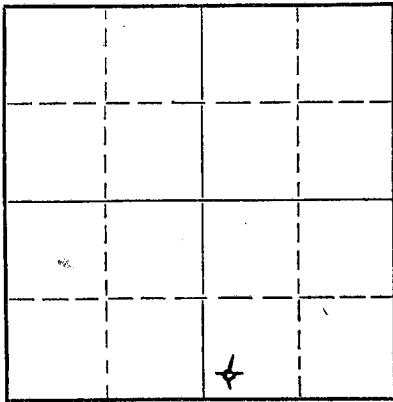

Locate well correctly on above Section Plat

If a producing well is abandoned, date of last production 19

Was permission obtained from the Conservation Division or its agents before plugging was commenced? Yes

Name of Conservation Agent who supervised plugging of this well Eldon Petty

Producing formation Depth to top Bottom Total Depth of Well 4050 Feet
Show depth and thickness of all water, oil and gas formations. PB to 3680'

OIL, GAS OR WATER RECORDS

CASING RECORD

FORMATION	CONTENT	FROM	TO	SIZE	PUT IN	PULLED OUT
		0	187'	8 5/8"	187'	None
		0	3847'	5 1/2"	3847'	1021'

Describe in detail the manner in which the well was plugged, indicating where the mud fluid was placed and the method or methods used in introducing it into the hole. If cement or other plugs were used, state the character of same and depth placed, from feet to feet for each plug set.

From 3680' to 3600' - Sand
3600' to 3568' - 4 Sacks Cement
3560' to 189' - Heavy Rotary Mud
189' to 187' - Rock Bridge
187' to 141' - 15 Sacks Cement
141' to 36 1/2' - Heavy Rotary Mud
36 1/2' to 35' - Wooden Plug
35' to 6' - 10 Sacks Cement
6' to Surface - Cellar

(If additional description is necessary, use BACK of this sheet)

Name of Plugging Contractor Bert Self
Address R.R. #4, Hutchinson, Kansas

STATE OF Kansas, COUNTY OF Barton, ss.
William Herbert (employee of owner) or (owner or operator) of the above-described well, being first duly sworn on oath, says: That I have knowledge of the facts, statements, and matters herein contained and the log of the above-described well as filed and that the same are true and correct. So help me God.

(Signature) *Wm Herbert*
P.O. Box 359, Hoisington, Kansas
(Address)

SUBSCRIBED AND SWORN to before me this 26th day of May, 1953

My commission expires June 4, 1955

My commission expires

24-7366-S 3-53-20M



RECEIVED
STATE CORPORATION COMMISSION

MAY 28 1953 5-23-53

CONSERVATION DIVISION
Wichita, Kansas

PLUGGING
FILE SEC 25 T 9 R 224
BOOK PAGE 66 LINE 8

Notary Public.

DRILLER'S LOG

15-065-00292-00-00

Company: Peel-Hardman Oil Producers
Farm: Gustafson "B" Well No. 1
Total Depth: 4050'
Comm.: 11-13-52 Comp.: 12-5-52
Contractor: Glenn W. Peel
Casing: 8 5/8" 187' cem.
5 1/2" 3847' cem.

SW SW SE
Sec. 25 , Twp 9S , Rge 22W
County: Graham,
Kansas
Elevation:
Production:

Figures below indicate bottom of formations

Surface Soil and Water Sands	0 -	110
Shale		700
Sand and Shale		1125
Shale and Shells		1275
Shale and Sand		1830
Anhydrite		1855
Shale and Shells		2255
Shale and Lime Streaks		2725
Lime and Shale		2970
Lime		3190
Shale and Lime Streaks		3405
Lime		3470
Lime and Shale Streaks		3540
Lime		3815
Conglomerate		3875
Lime		3920
Conglomerate		4050
Total Depth		4050

Moved cable tools in 11-28-52. Swabbed and bailed hole down and ran Lane-Wells Log 11-30-52. Perforated w/12 shots 3771' to 3775' and 12 shots from 3773'-3777'. Acidizing w/500 gals. Swabbing, testing and bailing 12-1-52, making 6 gals. water w/scum oil per hour. Acidizing w/2,000 gals. Swabbing and testing after acid on 12-2-52, making approximately 3/4 bbls water w/scum oil per hour. Acidizing w/500 gals. Swabbing and testing, no increase. Plug back to 3680' 12-4-52. Perforated w/24 shots from 3612' to 3620', acidizing w/500 gals. 12-5-52 - checking fluid level and swabbing, no oil, completed as dry hole.

This is to certify that the above information is to the best of our knowledge, true and correct.

GLENN W. PEEL

BY: W. Herbert

SUBSCRIBED AND SWORN to before me this 26th day of May, 1953.

My commission expires June 4, 1955.

Marian M. Herbert
Notary Public

RECEIVED
STATE CORPORATION COMMISSION

MAY 23 1953

CONSERVATION DIVISION
Wichita, Kansas

S-28-53



PLUGGING
FILE SEC 25 T 9 R 22W
BOOK PAGE 66 LINE 8