

15-065-20511-00-00


Give All Information Completely
Make Required Affidavit
Mail or Deliver Report to:
Conservation Division
State Corporation Commission
212 No. Market
Wichita, Kansas 67202

WELL PLUGGING RECORD

Graham County, Sec. 28 Twp. 9 Rge. 22 (E) W (W)

Location as "NE/CNW%SW%" or footage from lines C NW NW
Lease Owner Dreiling Oil, Inc.
Lease Name Cook Well No. 1
Office Address Victoria, Kansas 67671
Character of Well (completed as Oil, Gas or Dry Hole) Dry Hole
Date well completed 1-25 1972
Application for plugging filed 1-25 1972
Application for plugging approved 1-25 1972
Plugging commenced 1-25 1972
Plugging completed 1-25 1972
Reason for abandonment of well or producing formation Dry Hole

If a producing well is abandoned, date of last production 19
Was permission obtained from the Conservation Division or its agents before plugging was commenced? yes

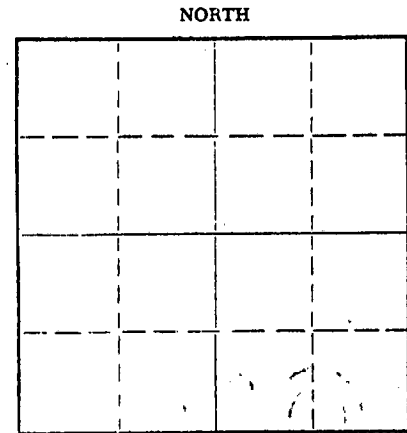

Locate well correctly on above Section Plat

Name of Conservation Agent who supervised plugging of this well Bill Nichols Morland, Kansas
Producing formation _____ Depth to top _____ Bottom _____ Total Depth of Well _____ Feet

Show depth and thickness of all water, oil and gas formations.

OIL, GAS OR WATER RECORDS

CASING RECORD

FORMATION	CONTENT	FROM	TO	SIZE	PUT IN	PULLED OUT
Surface Pipe				8 5/8	191'	

Describe in detail the manner in which the well was plugged, indicating where the mud fluid was placed and the method or methods used in introducing it into the hole. If cement or other plugs were used, state the character of same and depth placed, from _____ feet to _____ feet for each plug set.

1st plug was set @ 1,025' with 110 cu. ft. cement
2nd plug was set @ 215' with 30 cu. ft. cement
3rd plug was set @ 40' with 10 cu. ft. cement

RECEIVED
STATE CORPORATION COMMISSION
JAN 31 1972
CONSERVATION DIVISION
Wichita, Kansas

(If additional description is necessary, use BACK of this sheet)

Name of Plugging Contractor Dreiling Oil, Inc.
Address Victoria, Kansas 67671


STATE OF Kansas, COUNTY OF Ellis, ss.

I, Leo F. Dreiling, Pres. of Drlg. Contr. (employer or contractor) of the above-described well, being first duly sworn on oath, says: That I have knowledge of the facts, statements, and matters herein contained and the log of the above described well as filed and that the same are true and correct. So help me God.

(Signature) Leo F. Dreiling

LEO F. DREILING, Route #2 Victoria, Kansas 67671
(Address)

DESCRIBED AND SWORN TO before me this 29 day of January, 19 71

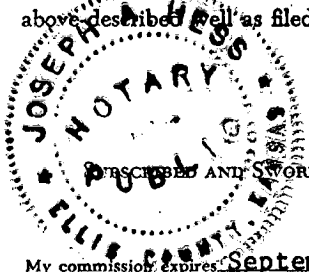

Joseph A. Hess
JOSEPH A. HESS Notary Public.

My commission expires September 14, 1974.

