


STATE OF KANSAS
 STATE CORPORATION COMMISSION
 Give All Information Completely
 Make Required Affidavit
 Fill or Deliver Report to:
 Conservation Division
 State Corporation Commission
 800 Bitting Building
 Wichita, Kansas

OR
FORMATION PLUGGING RECORD Strike out upper line when reporting plugging off formations.

Graham County, Sec. 33 Twp. 9S Rge. 22W (E) (W)

Location as "NE $\frac{1}{4}$ NW $\frac{1}{4}$ SW $\frac{1}{4}$ " or footage from lines NW NW SW
 Lease Owner Anderson-Prichard Oil Corporation
 Lease Name Loyd Well No. 1
 Office Address Oklahoma City, Oklahoma
 Character of Well (completed as Oil, Gas or Dry Hole) Dry hole
 Date well completed August 5, 1947
 Application for plugging filed (Verbal) August 24, (Approx.) 1947
 Application for plugging approved (Verbal) August 24, (Approx.) 1947
 Plugging commenced August 24, (Approx.) 1947
 Plugging completed August 25, 1947
 Reason for abandonment of well or producing formation Failed to produce commercially.
 If a producing well is abandoned, date of last production 19
 Was permission obtained from the Conservation Division or its agents before plugging was commenced? Yes

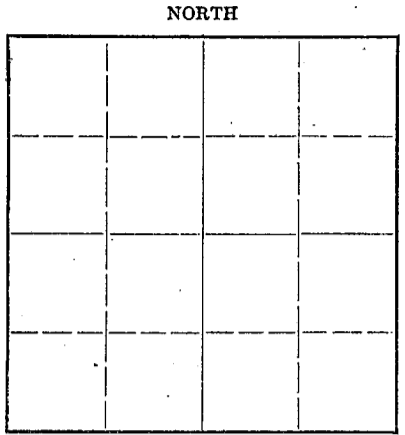

Locate well correctly on above Section Plat

Name of Conservation Agent who supervised plugging of this well C. D. Stough
 Producing formation _____ Depth to top _____ Bottom _____ Total Depth of Well 4117 Feet
 Show depth and thickness of all water, oil and gas formations.


OIL, GAS OR WATER RECORDS **CASING RECORD**

Formation	Content	From	To	Size	Put In	Pulled Out
Lansing	Oil & Water	3801	3807	8 5/8"	235	None
				5 1/2"	3899	1064'

Describe in detail the manner in which the well was plugged, indicating where the mud fluid was placed and the method or methods used in introducing it into the hold. If cement or other plugs were used, state the character of same and depth placed, from _____ feet to _____ feet for each plug set.

Tested Lansing through 48 casing perforations 3798-3810.
 After 500 and 2000 gal. acid treatments finally tested 3 bbls. oil and 6 bbls. water in 12 hours.

Shot off casing at 3000, 2900, 2800, 1500, 1200, and 1100'.
 Pulled 1064' of 5 1/2". Filled hole with heavy mud from bottom to 230'. Set Halliburton bridging plug at 230' and plugged with 10 sacks of cement. Filled hole with heavy mud to 15'. Set Halliburton bridging plug at 15' and plugged with 15 sacks of cement. Placed 5 sacks of cement in cellar.


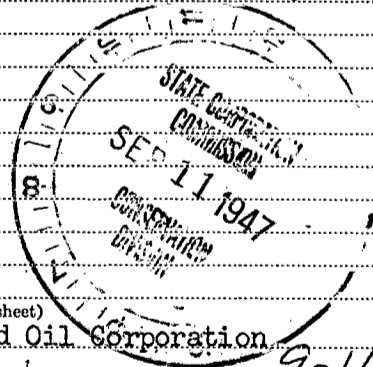


(If additional description is necessary, use BACK of this sheet)
 Correspondence regarding this well should be addressed to Anderson-Prichard Oil Corporation
 Address Oklahoma City, Oklahoma 9-11-47

STATE OF Kansas, COUNTY OF Sedgwick, ss.
M. W. Smith (employee of owner) or Conservation Division of the above-described well,
 being first duly sworn on oath, says: That I have knowledge of the facts, statements, and matters herein contained and the log of the above-described well as filed and that the same are true and correct. So help me God.

(Signature) [Signature]
Wichita, Kansas (Address)

SUBSCRIBED AND SWORN to before me this 9th day of September, 1947.
January 21, 1950.
Patricia Meeker Notary Public.

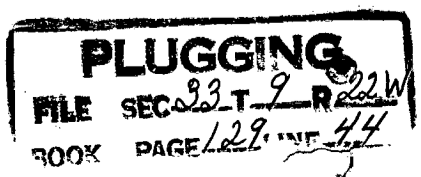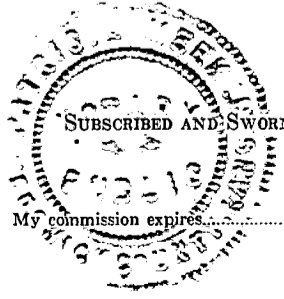

DRILLERS LOG OF FORMATIONS ENCOUNTERED IN

ANDERSON-PRITCHARD OIL CORPORATION

G. M. LOYD NO. 1

15 065-00057-00-00

U-34 1/4 NW/4 SW/4, SEC. 33-9S-22W


<u>FORMATION</u>	<u>FROM</u>	<u>TO</u>	
Clay & Shells	0	50	
Sand & Shells	50	100	
Shale	100	130	
Shale & Shells	130	235	Set 2-5/8" O.D. Casing
Brown Shale	235	700	235' and Cemented w/
Shale & Shells	700	1214	200 Sacks Cement.
Sandy Shale	1214	1265	
Shale & Shells	1265	1270	
Anhydrite	1270	1370	
Sand	1370	1570	
Shale & Shells	1570	1750	
Shale	1750	1895	
Anhydrite & Shale	1895	1945	
Shale	1945	3250	
Shale & Lime	2230	3115	
Shale	3115	3255	
Lime & Shale	3255	3590	
Shale	3590	3623	
Lime	3623	3835	
Shale & Lime	3835	4015	Set 3927' 5-1/2" O.D.
Conglomerate	4015	4020	Casing 3927' and
Lime	4020	4117	Cemented w/ 200 Sacks
			Cement.
	T.D.	4117	

Contractor - Transit Corporation
 1000 Tower
 Oklahoma City, Okla.

9-11-47

I hereby certify the foregoing to be a true and correct
 driller's log of the formations encountered in the above well.

H. O. Norman
 H. O. Norman

Certified to before me this 29th day of July, 1947

Betty Jane Scott by Commission Expires March 7-1951
 Notary Public

 FILE SEC 33-9-22W
 BOOK PAGE 129 LINE 44