

15-065-00129-00-00

STATE OF KANSAS
STATE CORPORATION COMMISSION


Give All Information Completely
Make Required Affidavit
Mail or Deliver Report to:
Conservation Division
State Corporation Commission
800 Bitting Building
Wichita, Kansas

WELL PLUGGING RECORD

Graham County, Sec. 33 Twp. 9S Rge. 22 (E) (W)

Location as "NE/CNW $\frac{1}{4}$ SW $\frac{1}{4}$ " or footage from lines SW $\frac{1}{4}$ SW $\frac{1}{4}$ SW $\frac{1}{4}$
Lease Owner Heathman Drilling Co., Inc.
Lease Name LOYD Well No. 1
Office Address 509 Orpheum Bldg., Wichita, Kansas
Character of Well (completed as Oil, Gas or Dry Hole) dry hole
Date well completed 10-6-1950
Application for plugging filed 10-6-1950
Application for plugging approved 10-6-1950
Plugging commenced 10-6-1950
Plugging completed 10-6-1950
Reason for abandonment of well or producing formation

NORTH

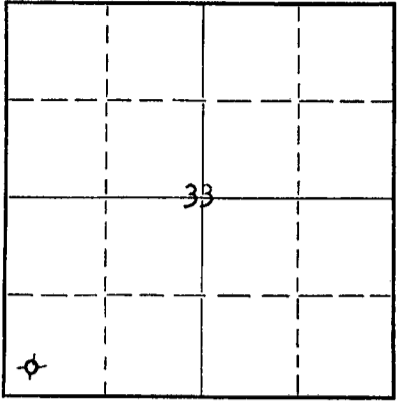

Locate well correctly on above Section Plat

If a producing well is abandoned, date of last production --- 19
Was permission obtained from the Conservation Division or its agents before plugging was commenced? yes

Name of Conservation Agent who supervised plugging of this well M. A. Rives
Producing formation none Depth to top --- Bottom --- Total Depth of Well 4077 Feet
Show depth and thickness of all water, oil and gas formations.

OIL, GAS OR WATER RECORDS

CASING RECORD

Formation	Content	From	To	Size	Put In	Pulled Out
none	---	---	---	8-5/8" (126') cemented @ 122' w/100 sacks bulk cement and 1 sack Cal. Chloride.		none
				no oil string		

Describe in detail the manner in which the well was plugged, indicating where the mud fluid was placed and the method or methods used in introducing it into the hole. If cement or other plugs were used, state the character of same and depth placed, from --- feet to --- feet for each plug set.

Filled hole with mud to bottom of surface; set plug @ 120' and cemented to bottom of cellar.

RECEIVED
STATE CORPORATION COMMISSION
OCT 13 1950
CONSERVATION DIVISION
Wichita, Kansas

(If additional description is necessary, use BACK of this sheet)

Correspondence regarding this well should be addressed to Heathman Drilling Co., Inc. 10-13-50
Address 509 Orpheum Bldg., Wichita, Kansas

STATE OF Kansas, COUNTY OF Sedgwick, ss.
Robert F. Walters (employee of owner) of the above-described well, being first duly sworn on oath, says: That I have knowledge of the facts, statements, and matters herein contained and the log of the above-described well as filed and that the same are true and correct. So help me God.

(Signature) Robert F. Walters
509 Orpheum Bldg., Wichita, Kansas
(Address)

SUBSCRIBED AND SWORN TO before me this 11th day of October, 1950

June 28, 1952

D. Marjorie Matt
Notary Public.

My commission expires

28-8273-s 4-50-10M

PLUGGING
FILE SEC. 33 T. 9 R. 22
BOOK PAGE 34 LINE 16

LOYD WELL # 1

Location:	SW/4 SW/4 SW/4 Sec.33-98-22W Graham County, Kansas	Spudded:	9-26-50
Operator:	Heathman Drilling Co., Inc.	Completed:	10-7-50
Contractor:	Heathman Drilling Co., Inc.	Elevation:	2351'KB
Surface Casing:	8-5/8" (6 jts.) cemented at 122' with 100 sacks bulk cement and 1 sack Cal. Chloride.	Total Depth:	4077'
Oil String:	None run - Dry and abandoned 10-7-50		

T O P S (KB)

Anhydrite	1875 (+ 476)
Topeka	3347 (- 996)
Heebner	3576 (-1225)
Lansing-Kansas City	3615 (-1264)
Base Kansas City	3848 (-1497)
Marmaton Chert	3920 (-1563)
Conglomerate	4003 (-1652)
Total Depth	4077 (-1726)

L O G

(Figures indicate bottom of formation)

Sand and shale	0 to 122'
Sand and shale	350
Shale and sand	900
Sand	940
Sand and shale	1032
Shale, sand and red bed	1460
Sand	1625
Shale and shells	1875
Anhydrite	1922
Shale and shells	2650
Lime and shale	3729
Lime	3833
Lime and shale	3898
Lime and chert	3950
Lime and shale	4031
Conglomerate	4077
Total Depth	4077'

The Undersigned, Robert F. Walters, of the Heathman Drilling Co., Inc., hereby certifies that the above log is a true and correct log of the formations encountered in drilling the above noted well as reflected by the Daily Drilling Reports.


HEATHMAN DRILLING CO., INC.

By Robert F. Walters

Subscribed and sworn to before
me on this 11th day of October
1950.

D. Marjorie Matt
Notary Public

My commission expires: June 28, 1952.

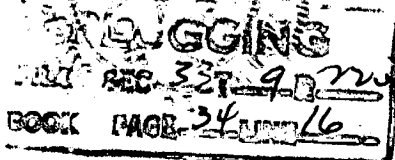

RECEIVED
STATE CORPORATION COMMISSION

OCT 13 1950

CONSULTING ENGINEER
10-13-50