


15-065-00373-00-00

STATE OF KANSAS
STATE CORPORATION COMMISSION

WELL PLUGGING RECORD

Give All Information Completely
Make Required Affidavit
Mail or Deliver Report to:
Conservation Division
State Corporation Commission
800 Bitting Building
Wichita, Kansas

Graham County. Sec. 2 Twp. 9 Rge. 22 (EX) W (W)
Location as "NE/CNWxSWx" or footage from lines SW SE NE
Lease Owner Brooks Hall
Lease Name Thompson Well No. 1
Office Address Box 1499 Oklahoma City, Okla.
Character of Well (completed as Oil, Gas or Dry Hole) Dry Hole
Date well completed 6-4 19 53
Application for plugging filed 6-3 19 53
Application for plugging approved 6-3 19 53
Plugging commenced 6-4 1.00 A.M. 19 53
Plugging completed 6-4 7.00 A.M. 19 53
Reason for abandonment of well or producing formation Dry Hole

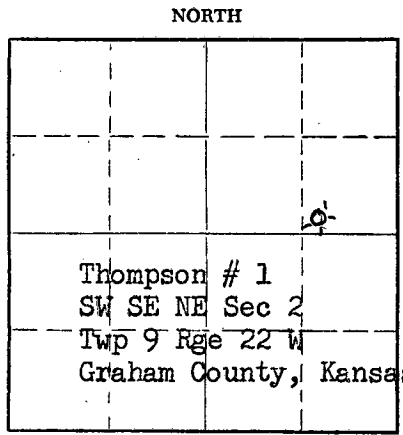

Locate well correctly on above Section Plat

If a producing well is abandoned, date of last production _____ 19 ____
Was permission obtained from the Conservation Division or its agents before plugging was commenced? Yes Verbal

Name of Conservation Agent who supervised plugging of this well Eldon Petty
Producing formation _____ Depth to top _____ Bottom _____ Total Depth of Well 3841 Feet
Show depth and thickness of all water, oil and gas formations.

OIL, GAS OR WATER RECORDS

CASING RECORD

FORMATION	CONTENT	FROM	TO	SIZE	PUT IN	PULLED OUT
Postrock shale		0	153	8 5/8	153'	None
Anhydrite		1755	1796			
Shale & Shells		1796	2460			
Lime		2460	3820			
Marmatorm		3820	3841			
Total Depth		3841				

Describe in detail the manner in which the well was plugged, indicating where the mud fluid was placed and the method or methods used in introducing it into the hole. If cement or other plugs were used, state the character of same and depth placed, from _____ feet to _____ feet for each plug set.

Stirred pits well Filled hole with heavy mud set wood plug @ 150' ran 1/2 sack hulls and 15 sacks cement. Filled hole with heavy mud, set wood plug @ 40' ran 1/2 sack hulls and 10 sacks of cement filling hole to the bottom of the cellar.

(If additional description is necessary, use BACK of this sheet)

Name of Plugging Contractor Strain Drilling Co.
Address Box 188 Hays, Kansas.

STATE OF Kansas. COUNTY OF Ellis, ss.
T. C. Strain (employee of owner) or (owner or operator) of the above-described well, being first duly sworn on oath, says: That I have knowledge of the facts, statements, and matters herein contained and the log of the above-described well as filed and that the same are true and correct. So help me God.

(Signature) T. C. Strain
Box 188 Hays, Kansas.
(Address)

SUBSCRIBED AND SWORN TO before me this 5th day of June, 19 53

My commission expires March 26, 1956

Method Schneider
Notary Public.
STATE CORPORATION COMMISSION

PLUGGING
FILE SEC 2 T 9 R 22W
BOOK PAGE 106 LINE 20

JUN 6 1953
6-6-53
CONSERVATION DIVISION
Wichita, Kansas

15-065-00373-00-00

WELL LOG

COMPANY: Brooks Hall
LEASE: Thompson # 1

SW SE NE Sec 2
Twp 9 Rge 22
Graham County, Kansas.

ELEVATION: 2241 R. B.

NOTE: All meas Rotary Bushing

0	60 Postrock & Shale	3668	3725 Lime
60	153 Blue Shale	3725	3780 Shale & Lime
153	155 Blue Shale	3780	3820 Lime
155	720 Shale & Shells	3820	3841 Marmaton
720	1035 Shale & Shells	3841 (Total Depth)	
1035	1055 Lime		
1055	1100 Sand & Shale		
1100	1160 Sand (Hard)		
1160	1520 Shale, Redbed & Sand	COMMENCED: 5-26-53	
1520	1755 Redbed & Shells	COMPLETED: 6-4-53	
1755	1796 Anhydrite		
1796	1905 Shale & Shells		
1905	2040 Shale & Shells	CASING RECORD: -----	
2040	2165 Lime & Shale		
2165	2260 Lime & Shale	8 5/8 Surface Casing set at 153' w/100	
2260	2460 Lime & Shale	sacks of cement by Sun Cementing Co.	
2460	2610 Lime		
2610	2700 Lime & Shale	No Electric Logs Run	
2700	2890 Lime & Shale		
2890	2995 Lime & Shale		
2995	3100 Lime & Shale	Geologist: Steve Powell	
3100	3190 Lime & Shale		
3190	3335 Lime & Shale		
3335	3420 Lime & Shale		
3420	3475 Lime		
3475	3526 Lime		
3526	3578 Lime		
3578	3625 Lime		
3625	3668 Lime		

TOPS:

Anhydrite	1755 (-486)	Lansing K. C.	3486 (-1245)
Heebner	3446 (-1205)	Base K. C.	3702 (-1461)
Toronto	3470 (-1229)	Total Depth	3841 (-1600)

Total Depth 3841 (-1600) in Marmaton

STATE OF KANSAS) SS
COUNTY OF ELLIS)

I hereby arrirm that the above and foregoing is a true and correct copy of the log of the Thompson # 1, located SW SE NE, Sec 2, Twp 9, Rge 22, Graham County, Kansas.

CONTRACTOR: Strain Drilling Co.

BY: T. C. Strain
T. C. Strain

Subscribed and sworn to before me this 5th day of June 1953.
My commission expires March 26, 1956

Mildred Schneider
Notary Public.

STATE COMMISSION
JUN X 6 1953
CONSERVATION DIVISION
Wichita, Kansas

6-6-53
PLUGGING
FILE SEC 2 T 9 R 22
BOOK PAGE 106 LINE 20