

15-068-20426-00-00

STATE OF KANSAS  
STATE CORPORATION COMMISSION

Form CP-4


Give All Information Completely  
Make Required Affidavit  
Mail or Deliver Report to:  
Conservation Division  
State Corporation Commission  
212 No. Market  
Wichita, Kansas 67202

WELL PLUGGING RECORD

Graham County, Sec. 3 Twp. 9S Rge. ~~XXX~~ 22 (W)

Location as "NE/CNW&SW¼" or footage from lines C NW SE  
Lease Owner Pickrell Drilling Company  
Lease Name Worland "A" Well No. 1  
Office Address 705 Fourth National Bank Bldg., Wichita, Kansas 67202  
Character of Well (completed as Oil, Gas or Dry Hole) Dry Hole  
Date well completed April 13 19 71  
Application for plugging filed April 13 19 71  
Application for plugging approved April 13 19 71  
Plugging commenced April 13 19 71  
Plugging completed April 13 19 71  
Reason for abandonment of well or producing formation Dry Hole

If a producing well is abandoned, date of last production 19  
Was permission obtained from the Conservation Division or its agents before plugging was commenced? Yes

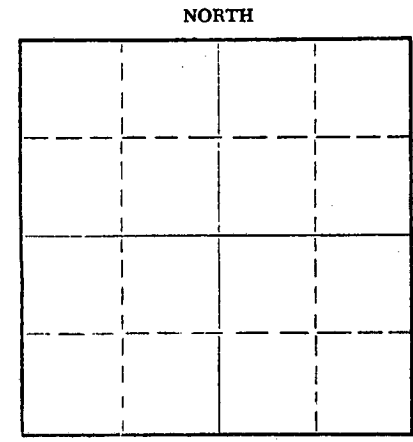

Locate well correctly on above Section Plat

Name of Conservation Agent who supervised plugging of this well W. L. Nichols  
Producing formation \_\_\_\_\_ Depth to top \_\_\_\_\_ Bottom \_\_\_\_\_ Total Depth of Well 3838 Feet  
Show depth and thickness of all water, oil and gas formations.

OIL, GAS OR WATER RECORDS

CASING RECORD

FORMATION	CONTENT	FROM	TO	SIZE	PUT IN	PULLED OUT
				8-5/8"	250'	None

Describe in detail the manner in which the well was plugged, indicating where the mud fluid was placed and the method or methods used in introducing it into the hole. If cement or other plugs were used, state the character of same and depth placed, from \_\_\_\_\_ feet to \_\_\_\_\_ feet for each plug set.

Bottom Plug @ 875' w/70 sacks, Middle Plug @ 275' w/25 sacks,  
Top Plug @ 40' w/10 sacks.

RECEIVED  
STATE CORPORATION COMMISSION  
APR 20 1971  
CONSERVATION DIVISION  
Wichita, Kansas

4-20-71


Name of Plugging Contractor Pickrell Drilling Company  
Address 705 Fourth National Bank Bldg., Wichita, Kansas 67202

STATE OF Kansas, COUNTY OF Sedgwick, ss.  
Dale M. Robinson (employee of owner) or (owner or operator) of the above-described

well, being first duly sworn on oath, says: That I have knowledge of the facts, statements, and matters herein contained and the log of the above-described well as filed and that the same are true and correct. So help me God.

(Signature) Dale M. Robinson  
705 Fourth National Bank Bldg., Wichita, Kansas  
(Address)

SUBSCRIBED AND SWORN to before me this 19th day of April, 19 71

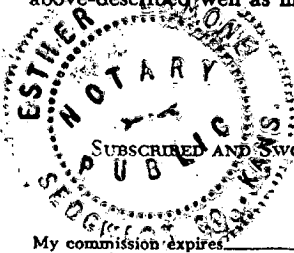

Esther Lamone  
Notary Public.

**ROTARY DRILLING LOG**

15-065-20426-00-00

**COMPANY:** Pickrell Drilling Company  
705 Fourth National Bank Building  
Wichita, Kansas 67202

Rotary Drilling Commenced 4/5/71

Rotary Drilling Completed 4/13/71

**LOCATION:** Worland "A" No. 1, C NW SE Section 3-9S-22W  
Graham County, Kansas

**CONTRACTOR:** **PICKRELL DRILLING COMPANY**  
Wichita, Kansas

**CASING RECORD:** Run 12 Jts. 8-5/8" surface casing set @ 250' KB . Cemented  
w/150 sacks. Completed 8:15 P.M. Circulated.

No oil string run. D & A Plugged down @ 10:00 P.M. April 13, 1971.

**LOG**

(Figures indicate bottom of formation — measurements from top of rotary bushing.)

-40	Shale	<u>C.F.S.</u>
250	Shale, Cement	3354
780	Shale, etc.	3492
1625	Shale & Sand	3510
1744	Shale	3590
1780	Anhydrite	3620
2300	Shale	3818
2525	Shale & Lime Stringers	3828
3120	Shale & Lime	3838
3335	Shale	
3510	Lime & Shale	
3620	Lime	
3818	Lime & Shale	
3838	Arbuckle, RTD	

Slope Tests

2000  
2500  
3000  
3500

RECEIVED  
STATE CORPORATION COMMISSION  
APR 20 1971  
CONSERVATION DIVISION  
Wichita, Kansas

420-71

The undersigned, Dale M. Robinson, Attorney-in-Fact for PICKRELL DRILLING COMPANY, hereby certifies in behalf of said Company, that the above is a true and correct log of the formation encountered in drilling the above well as reflected by the Daily Drilling Reports.

PICKRELL DRILLING COMPANY


By Dale M. Robinson  
Dale M. Robinson Attorney-in-Fact

STATE OF KANSAS }  
COUNTY OF SEDGWICK } ss.:

On this 19th day of April, 19 71, before me the undersigned, a Notary Public, in and for

the County and State aforesaid, personally appeared Dale M. Robinson, to me known to be the identical person who subscribed the name of PICKRELL DRILLING COMPANY to the foregoing instrument as its Attorney-in-Fact and acknowledged to me that he executed the same as his free and voluntary act and deed, and as the free and voluntary act and deed of such company, for the uses and purposes therein set forth.

Given under my hand and seal of office the day and year last above written.

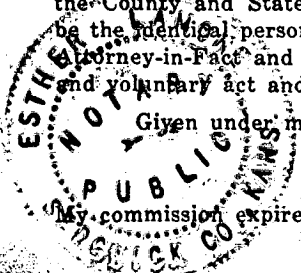

My commission expires: January 19, 1973

Esther Lamone  
Esther Lamone Notary Public