


WELL PLUGGING RECORD

Give All Information Completely
Make Required Affidavit
Mail or Deliver Report to:
Conservation Division
State Corporation Commission
211 No. Broadway
Wichita, Kansas

NORTH

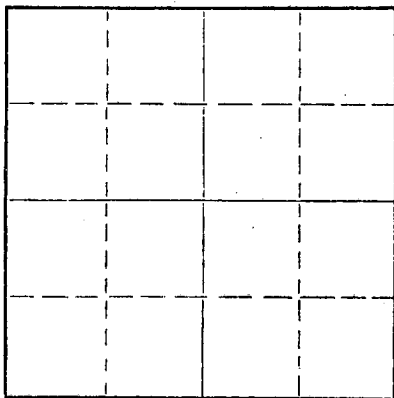

Locate well correctly on above
Section Plat

Graham County, Sec 5 Twp. 9S Rge. 22W (E) (W)
Location as "NE/CNW/SW" or footage from lines NE NE NE
Lease Owner Imperial Oil of Kansas, Inc.
Lease Name Rice Estate "F" Well No. 1
Office Address 780 Fourth National Bldg., Wichita 2, Kansas
Character of Well (completed as Oil, Gas or Dry Hole) Dry Hole
Date well completed August 21 1958
Application for plugging filed August 21 1958
Application for plugging approved August 21 1958
Plugging commenced August 21 1958
Plugging completed August 21 1958
Reason for abandonment of well or producing formation No commercial quantities of oil found.

If a producing well is abandoned, date of last production 19
Was permission obtained from the Conservation Division or its agents before plugging was commenced? Yes

Name of Conservation Agent who supervised plugging of this well A. D. Fabricius, Box 731, Hill City, Ks.
Producing formation _____ Depth to top _____ Bottom _____ Total Depth of Well 3932 Feet
Show depth and thickness of all water, oil and gas formations.

OIL, GAS OR WATER RECORDS

CASING RECORD

FORMATION	CONTENT	FROM	TO	SIZE	PUT IN	PULLED OUT
				8-5/8"	8-12-58	

Describe in detail the manner in which the well was plugged, indicating where the mud fluid was placed and the method or methods used in introducing it into the hole. If cement or other plugs were used, state the character of same and depth placed, from _____ feet to _____ feet for each plug set.

Set No. 1 plug at 550' with 25 sacks cement; Set No. 2 plug at 220' with 15 sacks cement; Set No. 3 plug at 40' with 10 sacks cement.

(If additional description is necessary, use BACK of this sheet)

Name of Plugging Contractor Imperial Oil of Kansas, Inc.
Address 780 Fourth National Building, Wichita 2, Kansas

STATE OF KANSAS, COUNTY OF SEDGWICK, ss.
Raymond L. Bacon (employee of Imperial Oil of Kansas, Inc. of the above-described well, being first duly sworn on oath, says: That I have knowledge of the facts, statements, and matters herein contained and the log of the above-described well as filed and that the same are true and correct. So help me God. IMPERIAL OIL OF KANSAS, INC.

(Signature) Raymond L. Bacon V-P
780 Fourth Nat'l. Bldg., Wichita 2, Kansas
(Address)



SUBSCRIBED AND SWORN to before me this 5th day of September, 19 58
July 7, 1962
My commission expires _____

Mona L. Latier
Mona L. Latier Notary Public.

PLUGGING
FILE SEC 5 T 9 R 22W
BOOK PAGE 126 LINE 43

RECEIVED
STATE CORPORATION COMMISSION
SEP 6 1958
9-6-58
CONSERVATION DIVISION
Wichita, Kansas

DRILLER'S LOG

15-065-02240-00-00

Imperial Oil of Kansas, Inc.
780 Fourth National Building
Wichita 2, Kansas

Rice "F" No. 1
NE NE NE Sec. 5-9S-22W
Graham County, Kansas

Total Depth: 3932'

Elevation 2285' RB
Production: D & A

Commenced: 8-11-58 Completed: 8-21-58

Contractor: Imperial Oil of Kansas, Inc.
Wichita 2, Kansas

Casing Record: Set 8-5/8" Surface Pipe at 216' with 175 sacks cement.

Figures indicate bottom of formations:

		<u>TOPS</u>	
Surface Sand	216'	Anhydrite	1865' (/ 420)
Shale & Sand	1400'	Heebner	3500' (-1215)
Dakota Sand	1605'	Toronto	3523' (-1238)
Shale & Shells	1865'	Lansing	3535' (-1250)
Anhydrite	1899'	Marmaton	3820' (-1535)
Shale & Shells	2460'	Conglomerate	3861' (-1576)
Shale & Lime	3520'	Rotary Total Depth	3932' (-1647)
Lime	3932'		
Total Depth	3932'		

We hereby certify this to be a correct and accurate log of the above described well as shown on the daily drilling reports.

IMPERIAL OIL OF KANSAS, INC.

By: Ray E. Bacon
Vice President

Subscribed and sworn to before me this 2nd day of September, 1958.

My Commission Expires:

July 7, 1962

Mona L. Latier
Notary Public

RECEIVED
STATE CORPORATION COMMISSION

SEP 6 9-6-58 1958

CONSERVATION DIVISION
Wichita, Kansas

PLUGGING	
FILE	SEC 5 T 9 R 22W
BOOK	PAGE 126 LINE 43