


15-065-20147-00-00

Give All Information Completely
Make Required Affidavit
Mail or Deliver Report to:
Conservation Division
State Corporation Commission
211 No. Broadway
Wichita, Kansas

WELL PLUGGING RECORD

Graham County. Sec. 9 Twp. 9S. Rge. (E)22 (W)
Location as "NE/CNW/SW" or footage from lines NE/4 SE/4
Lease Owner Raymond Oil Company, Inc.
Lease Name Rice Estate 'A' Well No. 1
Office Address 410 Fourth National Bank Bldg., Wichita, Kansas
Character of Well (completed as Oil, Gas or Dry Hole) Dry Hole
Date well completed June 5, 19 68
Application for plugging filed June 5, 19 68
Application for plugging approved June 5, 19 68
Plugging commenced June 5, 19 68
Plugging completed June 6, 19 68
Reason for abandonment of well or producing formation Dry Hole

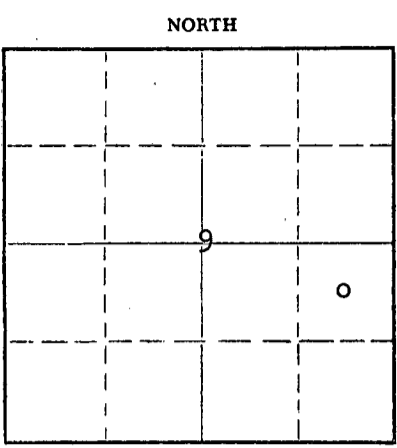

Locate well correctly on above Section Plat

If a producing well is abandoned, date of last production -- 19
Was permission obtained from the Conservation Division or its agents before plugging was commenced? Yes

Name of Conservation Agent who supervised plugging of this well Bill Nichols
Producing formation Depth to top Bottom Total Depth of Well 2580 Feet
Show depth and thickness of all water, oil and gas formations.

OIL, GAS OR WATER RECORDS

CASING RECORD
RECEIVED
JUN 12 1968
STATE CORPORATION COMMISSION
CONSERVATION DIVISION
Wichita, Kansas

FORMATION	CONTENT	FROM	TO	SIZE	PULLED OUT


Describe in detail the manner in which the well was plugged, indicating where the mud fluid was placed and the method or methods used in introducing it into the hole. If cement or other plugs were used, state the character of same and depth placed, from feet to feet for each plug set.

Mudded up to 1065'. Set plug with 70 sacks cement.
Mudded up to 245'. Set plug with 20 sacks cement.
Mudded up to 40'. Set plug and filled to bottom of cellar with cement.
Put two sacks cement in rat hole.

(If additional description is necessary, use BACK of this sheet)
Name of Plugging Contractor Halliburton Services
Address Hays, Kansas

STATE OF Kansas, COUNTY OF Sedgwick, ss.
F. S. Woodside, Jr., Contractor (employee of owner) or (owner or operator) of the above-described well, being first duly sworn on oath, says: That I have knowledge of the facts, statements, and matters herein contained and the log of the above-described well as filed and that the same are true and correct. So help me God.
(Signature) F. S. Woodside, Jr.
427 Union Center, Wichita, Kansas 67202
(Address)

SUBSCRIBED AND SWORN TO before me this 10th day of June, 1968.
My commission expires February 28, 1971.
Mary L. Lawrence, Notary Public.

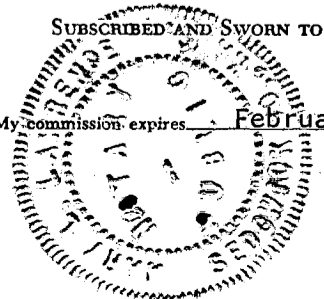

15-065-20147-00-00

ROTARY DRILLING LOG

Operator: Raymond Oil Company, Inc.
Rice Estate "A" #1
NE SE/4 9-9S-22W
Graham County, Kansas

Contractor: Omega Drilling, Inc.

Commenced: June 1, 1968
Completed: June 6, 1968

Casing Record:
8 5/8" casing cemented
at 223' with 185 sacks
cement.

FORMATIONS

232	Surface soil
1765	Shale and sand
1805	Shale
2122	Shale and Anhydrite
2580	Shale
2580	RTD

RECEIVED
STATE CORPORATION COMMISSION
JUN 12 1968
CONSERVATION DIVISION
Wichita, Kansas
6-12-68

We certify that the above log is true and correct to the best of our knowledge and belief.

OMEGA DRILLING, INC.

By *F. S. Woodside, Jr.*
F. S. Woodside, Jr.

Subscribed and sworn to before me, a notary public, in and for the state of Kansas, County of Sedgwick, this 11th day of June, 1968.

Mary L. Lawrence
Mary L. Lawrence, Notary Public

My commission expires: February 28, 1971.

