


15-065-02264 00-08

WELL PLUGGING RECORD

Give All Information Completely
Make Required Affidavit
Mail or Deliver Report to:
Conservation Division
State Corporation Commission
800 Bittling Building
Wichita, Kansas

NORTH

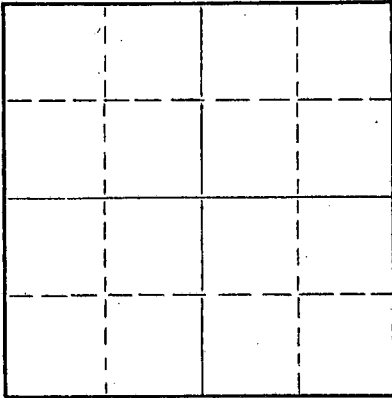

Locate well correctly on above
Section Plat

Graham County, Sec. 1 Twp. 9 Rge. 23 (E) (W)

Location as "NE/CNW%SW%" or footage from lines SW SE SW
Lease Owner Anschutz Drlg. Co.
Lease Name Beckett Well No. 1
Office Address 709 Union National Bank Bldg., Wichita, Kans.
Character of Well (completed as Oil, Gas or Dry Hole) Dry Hole
Date well completed 7-26 19 56
Application for plugging filed 7-26 19 56
Application for plugging approved 7-26 19 56
Plugging commenced 7-26 10:00 p.m. 19 56
Plugging completed 7-27 12:00 midnight 19 56
Reason for abandonment of well or producing formation Dry Hole

If a producing well is abandoned, date of last production _____ 19 ____
Was permission obtained from the Conservation Division or its agents before plugging was commenced? _____

Name of Conservation Agent who supervised plugging of this well Eldon Petty
Producing formation _____ Depth to top _____ Bottom _____ Total Depth of Well 3820 Feet
Show depth and thickness of all water, oil and gas formations.

OIL, GAS OR WATER RECORDS

CASING RECORD

FORMATION	CONTENT	FROM	TO	SIZE	PUT IN	PULLED OUT
				8-5/8	211	None

Describe in detail the manner in which the well was plugged, indicating where the mud fluid was placed and the method or methods used in introducing it into the hole. If cement or other plugs were used, state the character of same and depth placed, from _____ feet to _____ feet for each plug set.

Filled hole with heavy rotary mud to 210'. Dumped in 1/2 sack hulls-set plug-mixed 15 sacks cement by hand and poured through drill pipe.

Filled hole with heavy rotary mud to 40'. Dumped in 1/2 sack hulls-set plug-mixed 10 sacks cement. Filled hole to bottom of cellar.

RECEIVED
STATE CORPORATION COMMISSION
JUL 31 1956
7/31/56
CONSERVATION DIVISION
Wichita, Kansas

(If additional description is necessary, use BACK of this sheet)


Name of Plugging Contractor _____
Address _____

STATE OF KANSAS, COUNTY OF BARTON, ss.
S. C. Lingreen (employee of owner) or (owner or operator) of the above-described well, being first duly sworn on oath, says: That I have knowledge of the facts, statements, and matters herein contained and the log of the above-described well as filed and that the same are true and correct. So help me God.

(Signature) S. C. Lingreen
Great Bend, Kansas (Address)

SUBSCRIBED AND SWORN TO before me this 28th day of July, 19 56

My commission expires 6-25-59

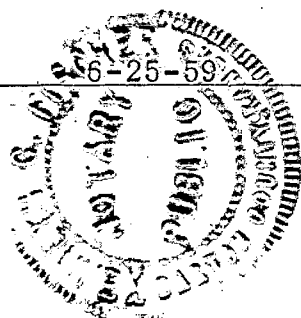

Kenneth G. Fischer Notary Public.

PLUGGING
FILE SEC 1 T 9 R 23w
BOOK PAGE 85 LINE 39

DRILLERS LOG

15-065-02264-00-00

Beckett No. 1
Loc: SW SE SW
Sec: 1-9S-23W
Graham County, Kansas
Company: Anschutz Drilg. Co., Inc., et al
Contractor: Nonaker-Davis Drilg. Co.

Comm: 7-18-56
Comp: 7-27-56
Rotary Total Depth: 3820'
Casing: 3-5/8" at 212'
D & A

0	30	Surface soil & Post rock	
30	100	Sand	8-5/8" casing cemented
100	215	Blud Shale	at 212' with 175 sacks
215	1300	Shale & Shells	cement and 4 sacks
1300	1595	Shale & Red Bed	calcium chloride
1595	1805	Sand	
1805	3560	Lime & Shale	
3560	3605	Lime	
3605	3660	Lime & Shale	
3660	3715	Lime	
3715	3820	Lime & Shale	
3820		Total Rotary Depth	D & A

I certify that this is the true and correct copy of the above log to the best of my knowledge.

H. S. Forbes
H. S. Forbes

Subscribed and sworn to before me this 30th day of July, 1956.

Kenneth G. Fischer
Kenneth G. Fischer, Notary Public

My commission expires: 6-25-59

PLUGGING
FILE SEC. 1 T. 9 R. 23W
BOOK PAGE 85 LINE 39

7/31/56