

STATE CORPORATION COMMISSION OF KANSAS
OIL & GAS CONSERVATION DIVISION

WELL COMPLETION OR RECOMPLETION FORM
ACO-1 WELL HISTORY

DESCRIPTION OF WELL AND LEASE

Operator: license # 9121
name Kiwanda Resources Inc.
address Box 7265
City/State/Zip Wichita, KS 67207

Operator Contact Person C. Kirk Fraser
Phone (316) 267-2697

Contractor: license # 6033
name Murfin Drilling

Wellsite Geologist C. Kirk Fraser
Phone (316) 685-4905

PURCHASER

Designate Type of Completion

New Well Re-Entry Workover

Oil SWD Temp Abd
 Gas Inj Delayed Comp.
 Dry Other (Core, Water Supply etc.)

If OWWO: old well info as follows:

Operator
Well Name
Comp. Date Old Total Depth

WELL HISTORY

Drilling Method: Mud Rotary Air Rotary Cable

10/27/84 11/2/84 11/2/84
Spud Date Date Reached TD Completion Date

3655
Total Depth PBSD

Amount of Surface Pipe Set and Cemented at 258 feet

Multiple Stage Cementing Collar Used? Yes No

If Yes, Show Depth Set feet

If alternate 2 completion, cement circulated from feet depth to w/ SX cmt

API NO. 15-163-22,534-0000

County Rooks

NE SE NE Sec 19 Twp 9S Rge 18 X West
(location)

3630 Ft North from Southeast Corner of Section
330 Ft West from Southeast Corner of Section
(Note: locate well in section plat below)


Lease Name Wilkenson Well# 1

Field Name Baumgarten

Producing Formation

Elevation: Ground 2176 KB 2181

Section Plat

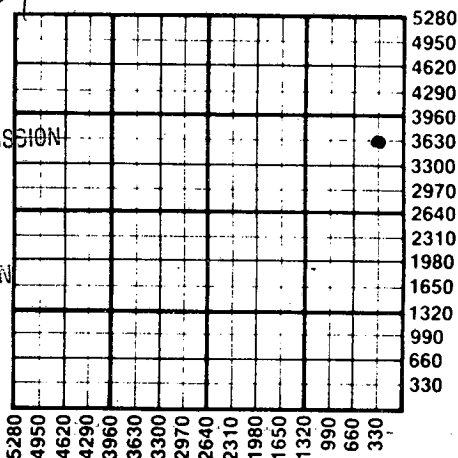

RECEIVED
STATE CORPORATION COMMISSION
DEC 10 1984

CONSERVATION DIVISION
Wichita, Kansas

WATER SUPPLY INFORMATION

Source of Water:
Division of Water Resources Permit #

Groundwater Ft North From Southeast Corner and
(Well) Ft West From Southeast Corner of
Sec Twp Rge East West

Surface Water Ft North From Southeast Corner and
(Stream, Pond etc.) Ft West From Southeast Corner
Sec Twp Rge East West

Other (explain) City water from Plainville...
(purchased from city, R.W.D.#)

Disposition of Produced Water: Disposal Repressuring

Docket #

INSTRUCTIONS: This form shall be completed in duplicate and filed with the Kansas Corporation Commission, 200 Colorado Derby Building, Wichita, Kansas 67202, within 90 days after completion or recompletion of any well. Rules 82-3-130 and 82-3-107 apply.

Information on side two of this form will be held confidential for a period of 12 months if requested in writing and submitted with the form. See rule 82-3-107 for confidentiality in excess of 12 months.


One copy of all wireline logs and drillers time log shall be attached with this form. Submit CP-4 form with all plugged wells. Submit CP-111 form with all temporarily abandoned wells.

All requirements of the statutes, rules, and regulations promulgated to regulate the oil and gas industry have been fully complied with and the statements herein are complete and correct to the best of my knowledge.

Signature [Signature] Title PRESIDENT Date 10/5/84

Subscribed and sworn to before me this 5th day of December 19 84

Notary Public Date Commission Expires

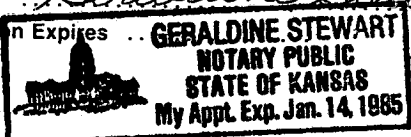

K.C.C. OFFICE USE ONLY
F Letter of Confidentiality Attached
C Wireline Log Received
C Drillers Timelog Received
Distribution
 KCC SWD/Rep NGPA
 KGS Plug Other (Specify)

Sec. 9 Twp. 9 Rge. 18 W

SIDE TWO

Operator Name Kiwanda Resources, Inc Lease Name Wilkenson Well# 1 SEC 19 TWP 9S RGE 18 East West

WELL LOG

INSTRUCTIONS: Show important tops and base of formations penetrated. Detail all cores. Report all drill stem tests giving interval tested, time tool open and closed, flowing and shut-in pressures, whether shut-in pressure reached static level, hydrostatic pressures, bottom hole temperature, fluid recovery, and flow rates if gas to surface during test. Attach extra sheet if more space is needed. Attach copy of log.

Drill Stem Tests Taken Yes No
 Samples Sent to Geological Survey Yes No
 Cores Taken Yes No

Formation Description
 Log Sample

Name	Top	Bottom
Anhydrite	1560 (+621)	
Topeka	3119 (-938)	
Heebner	3328 (-1147)	
Toronto	3348 (-1167)	
Lansing/Kansas City	3372 (-1191)	
Arbuckle	3626 (-1445)	

DST #1 3360-3390
 30-30-15-15
 Recovered: 10' drilling mud
 IFP: 55-55
 FFP: 55-55
 SIP: 76-55
 HP: 1874-1853
 BHT: 118°

DST #2 3620-3632
 Misrun

DST #3 3605-3635
 Recovered: 20' Drilling mud
 IFP: 55-55
 FFP: 55-55
 SIP: 98-66
 HP : 1938-1917
 BHT: 112°

CASING RECORD <input type="checkbox"/> new <input type="checkbox"/> used							
Report all strings set - conductor, surface, intermediate, production, etc.							
Purpose of string	size hole drilled	size casing set (in O.D.)	weight lbs/ft.	setting depth	type of cement	# sacks used	type and percent additives
Surface	12 1/4	8 5/8	20	258	"Sunset"	175	
PERFORATION RECORD				Acid, Fracture, Shot, Cement Squeeze Record			
shots per foot	specify footage of each interval perforated			(amount and kind of material used)			Depth
TUBING RECORD				Liner Run <input type="checkbox"/> Yes <input type="checkbox"/> No			
size	set at	packer at					
Date of First Production	Producing method <input type="checkbox"/> flowing <input type="checkbox"/> pumping <input type="checkbox"/> gas lift <input type="checkbox"/> Other (explain)						
Estimated Production Per 24 Hours	Oil	Gas	Water	Gas-Oil Ratio	Gravity		
	D & A						
	Bbls	MCF	Bbls	CFPB			

Disposition of gas: vented sold used on lease

METHOD OF COMPLETION open hole perforation other (specify)

PRODUCTION INTERVAL Dually Completed. Commingled

