

15-065-30176-00-00

STATE OF KANSAS
STATE CORPORATION COMMISSION

WELL PLUGGING RECORD

Give All Information Completely
Make Required Affidavit
Mail or Deliver Report to
Conservation Division
State Corporation Comm.
245 North Water
Wichita, KS 67202

Graham County. Sec. 26 Twp. 9s Rge. 25 E/W
Location as "NE/CNW $\frac{1}{4}$ /SW $\frac{1}{4}$ " or footage from lines
C SW, SE


Lease Owner Phoenix Resources Company
Lease Name Rome Well No. 1-26

Office Address 3524 N.W. 56 Suite 300 Okla. City, Okla.
Character of Well (Completed as Oil, Gas or Dry Hole)
Oil Well

Date Well completed NA 19
Application for plugging filed 10-22-1980 19
Application for plugging approved 11-3-1980 19
Plugging commenced 4-27-1981 19
Plugging completed 5-25-81 19

Reason for abandonment of well or producing formation
Uneconomical
If a producing well is abandoned, date of last production
4-2-80 19

Was permission obtained from the Conservation Division or
its agents before plugging was commenced? Yes

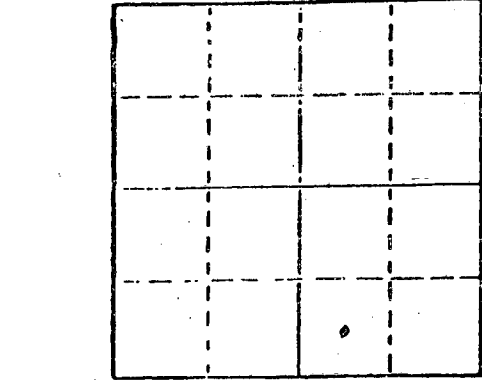

Locate well correctly on above
Section Plat

Name of Conservation Agent who supervised plugging of this well Gilbert Balthazor
Producing formation Kansas City Depth to top 3808 Bottom 4100 Total Depth of Well 4110
Show depth and thickness of all water, oil and gas formations.

OIL, GAS OR WATER RECORDS

CASING RECORD

FORMATION	CONTENT	FROM	TO	SIZE	PUT IN	PULLED OUT
Kansas City Lime	oil	3808	4050	4 $\frac{1}{2}$ "	4109	0

Describe in detail the manner in which the well was plugged, indicating where the mud fluid was placed and the method or methods used in introducing it into the hold. If cement or other plugs were used, state the character of same and depth placed, from 3000 feet to 2196 feet for each plug set. Mixed and pumped down annulus 20 sax. Mixed and pumped down casing 3 sax hulls and 80 sax cement. 4-28-81 checked and cement down aprox. 500'. Reported to Mr. Balthazor and he gave orders to fill casing with ready mix. Filled pipe to three ft. below ground level. Job completed 5-25-81

RECEIVED

STATE CORPORATION COMMISSION

(If additional description is necessary, use BACK of this sheet)

Name of Plugging Contractor PFEIFER WELL SERVICE INC. JUN-9 1981
06 09 1981
CONSERVATION DIVISION

STATE OF KANSAS COUNTY OF GRAHAM Wichita, Kansas, ss.
Deane O. Sharpe (employee of owner) or (owner or operator)

of the above-described well, being first duly sworn on oath, says: That I have knowledge of the facts, statements, and matters herein contained and the log of the above-described well as filed and that the same are true and correct. So help me God.

(Signature) Deane O. Sharpe
Box 4386 Hill City, Kansas 67642
(Address)

SUBSCRIBED AND SWORN TO before me this 30th day of April, 1981

My commission expires July 20, 1982

Mary Jackson
Notary Public.

