


WELL PLUGGING RECORD

Give All Information Completely
Make Required Affidavit
Mail or Deliver Report to:
Conservation Division
State Corporation Commission
800 Bitting Building
Wichita, Kansas

NORTH

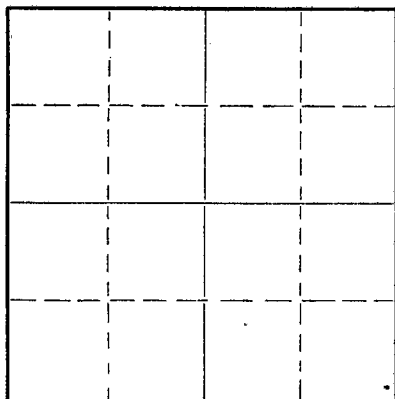

Locate well correctly on above
Section Plat

Graham County, Sec 29 Twp 9 Rge 25 (E) (W)
Location as "NE/CNW $\frac{1}{4}$ /SW $\frac{1}{4}$ " or footage from lines NE NE NE
Lease Owner Dunne-Gardner Drilling Co., Inc.
Lease Name Pfeifer Well No. 1
Office Address 300 Schweiter Building, Wichita 2, Kansas
Character of Well (completed as Oil, Gas or Dry Hole) Dry Hole
Date well completed October 9 19 58
Application for plugging filed October 9 19 58
Application for plugging approved October 9 19 58
Plugging commenced " 19
Plugging completed " 19
Reason for abandonment of well or producing formation Dry Hole

If a producing well is abandoned, date of last production 19
Was permission obtained from the Conservation Division or its agents before plugging was commenced? Yes

Name of Conservation Agent who supervised plugging of this well Albert Sabricius
Producing formation Depth to top Bottom Total Depth of Well 4160 Feet
Show depth and thickness of all water, oil and gas formations.

OIL, GAS OR WATER RECORDS

CASING RECORD

Formation	Content	From	To	Size	Put In	Pulled Out
Surface Pipe		0	219	8 5/8	"	

RECEIVED
STATE CORPORATION COMMISSION
OCT 28 1958
10-28-1958
CONSERVATION DIVISION

Describe in detail the manner in which the well was plugged, indicating where the mud fluid was placed and the method or methods used in introducing it into the hole. If cement or other plugs were used, state the character of same and depth placed, from feet to feet for each plug set.

Drilling Mud from 4160' to 600' Plug and 20 sx. cement, Mud to 215'
Plug and 20 sx. Cement, Mud to 40' Plug and 10 sx. Cement.

(If additional description is necessary, use BACK of this sheet)

Correspondence regarding this well should be addressed to
Address

STATE OF Kansas COUNTY OF Sedgwick, ss.
Don Gardner (employee of owner) or (owner or operator) of the above-described well,
being first duly sworn on oath, says: That I have knowledge of the facts, statements, and matters herein contained and the log of the above-described well as filed and that the same are true and correct. So help me God.

(Signature) *Don Gardner*
300 Schweiter Bldg. (Address)

SUBSCRIBED AND SWORN to before me this 13th day of October, 19 58
William H. Bennett
Notary Public.

My commission expires 27 July 1960

PLUGGING
FILE SEC 29 T 9 R 25 W
BOOK PAGE 136 LINE 25

DRILLER'S LOG

15-065-00485-00-00

Company: Dunne-Gardner Drilling Co., Inc.
 300 Schweiter Building
 Wichita, Kansas

Lease: Pfeifer

Well: No. 1

Location: NE NE NE of Section 29, Township 9 South,
 Range 25 West, Graham County, Kansas

Contractor: Dunne-Gardner Drilling Co., Inc.

Date Comm: 9-29-58

Date Comp: 10-9-58

T.D.: 4160 Feet

Casing: 220 Ft. - 8 5/8" Surface Casing
 w/150 Sks. Cement, 3 Sks. c.c.

From	To	
0	- 220	Shale, Sand & Pyrite
220	- 670	Shale
670	- 785	Sand & Sandy Lime
785	- 970	Red Bed & Shells
970	- 1330	Shale & Sand
1330	- 1430	Sand
1430	- 2067	Shale & Shells
2067	- 2252	Shale & Red Bed
2252	- 2290	Anhydrite
2290	- 2535	Shale & Shells
2535	- 2905	Shale & Lime
2905	- 3185	Lime & Shale
3185	- 3290	Shale & Lime
3290	- 3755	Lime & Shale
3755	- 4160	Lime
4160	-	T. D.

D&A

RECEIVED
 STATE CORPORATION COMMISSION
 OCT 28 1958
 CONSERVATION DIVISION
 Wichita, Kansas

I certify the above to be true and correct to the best of my knowledge.

DUNNE-GARDNER DRILLING CO., INC.

By *Don Gardner*
 Don Gardner

Subscribed and Sworn before me this 20th day of October, 1958.

William D. Bennett
 William D. Bennett
 Notary Public



My Commission Expires:

27 July 1960

PLUGGING
 FILE SEC 29T 9 R 25W
 BOOK PAGE 136 LINE 25