


Give All Information Completely
Make Required Affidavit
Mail or Deliver Report to:
Conservation Division
State Corporation Commission
P. O. Box 17027
Wichita, Kansas 67217
NORTH

WELL PLUGGING RECORD

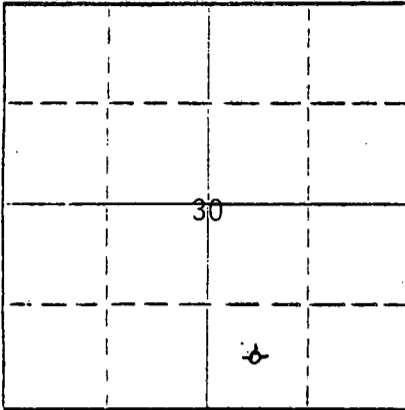

Locate well correctly on above Section Plat

Location as "NE/CNW/SW" or footage from lines Graham County, Sec. 30 Twp. 9S Rge. (E)25W (W)
Lease Owner DONALD C. SLAWSON
Lease Name Werth 'H' Well No. 1
Office Address 200 Douglas Building Wichita, Kansas 67202
Character of Well (completed as Oil, Gas or Dry Hole) Dry Hole
Date well completed May 12, 19 82
Application for plugging filed May 12, 19 82
Application for plugging approved May 12, 19 82
Plugging commenced May 12, 19 82
Plugging completed May 12, 19 82
Reason for abandonment of well or producing formation Dry Hole

If a producing well is abandoned, date of last production _____ 19____
Was permission obtained from the Conservation Division or its agents before plugging was commenced? Yes

Name of Conservation Agent who supervised plugging of this well Dennis Hamel
Producing formation _____ Depth to top _____ Bottom _____ Total Depth of Well 4090 Feet
Show depth and thickness of all water, oil and gas formations.

OIL, GAS OR WATER RECORDS

CASING RECORD

| FORMATION | CONTENT | FROM | TO | SIZE | PUT IN | PULLED OUT |
|-----------|---------|---------|------|--------|--------|------------|
| | | surface | 285' | 8 5/8" | | |
| | | | | | | |
| | | | | | | |
| | | | | | | |
| | | | | | | |
| | | | | | | |
| | | | | | | |

Describe in detail the manner in which the well was plugged, indicating where the mud fluid was placed and the method or methods used in introducing it into the hole. If cement or other plugs were used, state the character of same and depth placed, from _____ feet to _____ feet for each plug set.

1st plug @ 1250' w/70 sx
2nd plug @ 250' w/40 sx
Bridge @ 40' w/10 sx
10 sx in Rat Hole

RECEIVED
STATE CORPORATION COMMISSION

AUG 27 1982


CONSERVATION DIVISION
Wichita, Kansas

08-27-1982

Name of Plugging Contractor Halliburton Services (If additional description is necessary, use BACK of this sheet)
Address Box 579 Great Bend, Kansas 67530

STATE OF KANSAS, COUNTY OF SEDGWICK, ss.
William R. Horigan (employee of owner) or (owner or operator) of the above-described

well, being first duly sworn on oath, says: That I have knowledge of the facts, statements, and matters herein contained and the log of the above-described well as filed and that the same are true and correct. So help me, God.

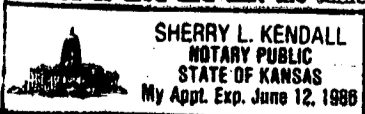

(Signature) William R Horigan
William R. Horigan 200 Douglas Building
(Address) Wichita, Kansas 67202

Subscribed and Sworn to before me this 2nd day of August, 19 82

My commission expires 06/12/86 Sherry L. Kendall Notary Public.