


WELL PLUGGING RECORD

Information Completely
Make Required Affidavit
Mail or Deliver Report to:
Conservation Division
State Corporation Commission
212 No. Market
Wichita, Kansas

NORTH

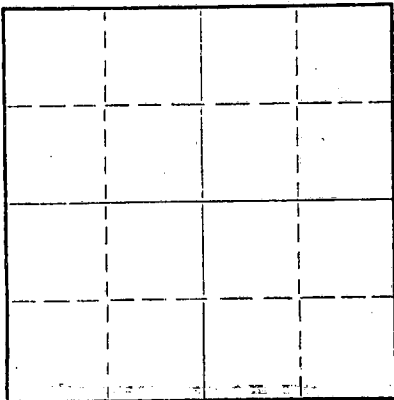

Locate well correctly on above
Section Plat

Graham County, Sec. 31 Twp. 9-S. Rge. 25-W (E) (W)
Location as "NE/CNW/SW" or footage from lines NE NE SW
Lease Owner Dean & Clark, Inc.
Lease Name Werth-Richmeier Well No. 1
Office Address 416 Union Center Building, Wichita, Kansas 67202
Character of Well (completed as Oil, Gas or Dry Hole) Dry hole
Date well completed February 27, 1968
Application for plugging filed February 27, 1968
Application for plugging approved 19
Plugging commenced February 27, 1968
Plugging completed February 27, 1968
Reason for abandonment of well or producing formation Dry hole

If a producing well is abandoned, date of last production 19
Was permission obtained from the Conservation Division or its agents before plugging was com-
menced? Yes

Name of Conservation Agent who supervised plugging of this well W. L. Nichols, Box 157, Morland, Kansas
Producing formation Depth to top Bottom Total Depth of Well Feet
Show depth and thickness of all water, oil and gas formations.

OIL, GAS OR WATER RECORDS

CASING RECORD

FORMATION	CONTENT	FROM	TO	SIZE	PUT IN	PULLED OUT

Describe in detail the manner in which the well was plugged, indicating where the mud fluid was placed and the method or methods used in introducing it into the hole. If cement or other plugs were used, state the character of same and depth placed, from feet to feet for each plug set.

Set wood plug at 1380 feet, cemented with 100 sx. 50-50 Pozmix, 6% Jel to 980 feet, filled hole with mud. Set wood plug at 215 feet. Cemented with 50 sx. 50-50 Pozmix, 6% Jel to 155 feet. Set wood plug at 40 feet, cemented with 10 sx. 50-50 Pozmix, 6% Jel to top of collar in cellar. Job completed at 11:30 A.M. 2-27-68.

RECEIVED
STATE CORPORATION COMMISSION
APR 11 1968
CONSERVATION DIVISION
Wichita, Kansas

04-11-1968

(If additional description is necessary, use BACK of this sheet)
Name of Plugging Contractor Dean & Clark, Inc.
Address 416 Union Center Building, Wichita, Kansas 67202


STATE OF Kansas, COUNTY OF Sedgwick, ss.
Jay C. Glark (employee of owner) or (owner or operator) of the above-described well, being first duly sworn on oath, says: That I have knowledge of the facts, statements, and matters herein contained and the log of the above-described well as filed and that the same are true and correct. So help me God.

(Signature) Jay C. Clark
416 Union Center Building, Wichita, Kansas
(Address)

SUBSCRIBED AND SWORN TO before me this 4th day of March, 1968

August 30, 1969

Phyllis Gillen
Phyllis Gillen, Notary Public.

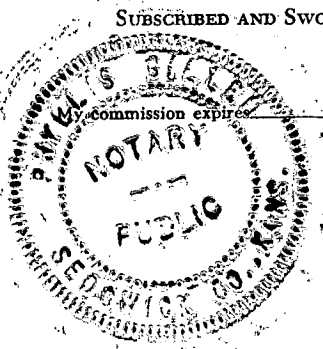

15-065-20125-00-00

DRILLERS LOG

COMPANY: Dean & Clark, Inc.
 CONTRACTOR: Company tools
 LEASE NAME: Werth-Richmeier No. 1
 LOCATION: NE NE SW, Section 31-9S-25W,
 Graham County, Kansas
 ELEVATION: 2591' D.F. - 2594' K.B.
 SURFACE CASING: 210 feet 8-5/8"
 COMMENCED: February 16, 1968
 COMPLETED: February 27, 1968
 ROTARY TOTAL DEPTH: 4105 feet

<u>FORMATION</u>	<u>DEPTH</u>	
Top Soil & Shale	210	Spudded at 11:30 A.M. 2-17-68.
Shale	2055	Set 8-5/8" Surface casing at 210 feet.
Shale-Red Bed	2231	Cemented with 160 sacks common Sunset
Anhydrite	2270	cement. Plug down at 4:00 P.M. 2-17-68.
Shale	2460	Cement circulated.
Lime-Shale	2683	
Shale-Lime	3315	DST #1: 3878-3909
Lime-Shale	3425	DST #2: 3930-3961
Lime	3503	DST #3: 4008-4036
Shale-Lime	3609	
Lime-Shale	3716	Ran electric log.
Lime	3777	
Lime-Shale	3830	Plugged hole at 11:30 A.M. 2-27-68.
Shale-Lime	3895	
Lime	3909	
Lime-Shale	3961	
Lime	4105	
RTD	4105	

<u>LOG TOPS</u>	<u>DEPTH</u>	<u>DATUM</u>
Anhydrite	2241	+ 353
Topeka	3617	-1023
Heebner	3831	-1237
Toronto	3854	-1260
Lansing	3870	-1276
Base Kansas City	4099	-1505
Log Total Depth	4108	-1514

RECEIVED
 STATE CORPORATION COMMISSION
 MAR 15 1968
 CONSERVATION DIVISION
 Wichita, Kansas

STATE OF KANSAS)
)
 COUNTY OF SEDGWICK) ss:

The undersigned, being duly sworn on oath, states that the above statement and log are a true and correct record and log of the well drilled at the location above described.

Jay C. Clark
 Jay C. Clark

Subscribed and sworn to before me this 4th day of March, 1968.

Phyllis Gillen
 Phyllis Gillen, Notary Public

