

Give All Information Completely  
Make Required Affidavit  
Mail or Deliver Report to:  
Conservation Division  
State Corporation Commission  
211 No. Broadway  
Wichita, Kansas

WELL PLUGGING RECORD

Graham County, Sec. 36 Twp. 9S Rge. 25W (E) (W)

Location as "NE/CNW/SW" or footage from lines C SW SE

Lease Owner J. A. Terteling & Sons

Lease Name J.J. Richmeier Well No. # 1

Office Address 320 Petroleum Club Bldg., Denver, Colorado

Character of Well (completed as Oil, Gas or Dry Hole) Dry Hole

Date well completed December 6 19 61

Application for plugging filed December 6 19 61

Application for plugging approved December 11 19 61


Plugging commenced December 6 19 61

Plugging completed December 6 19 61

Reason for abandonment of well or producing formation Dry Hole

If a producing well is abandoned, date of last production 19

Was permission obtained from the Conservation Division or its agents before plugging was commenced? Yes

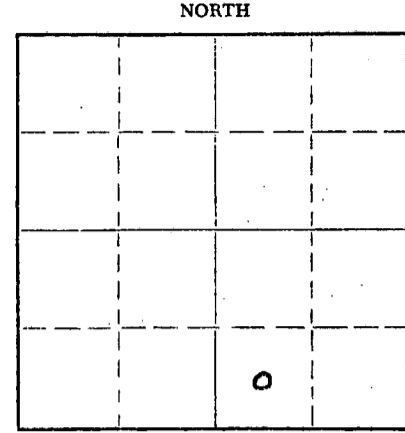

Locate well correctly on above Section Plat

Name of Conservation Agent who supervised plugging of this well Eldon Petty

Producing formation Lansing K.C. Depth to top 3814 Bottom 4047 Total Depth of Well 4055 Feet

Show depth and thickness of all water, oil and gas formations.

OIL, GAS OR WATER RECORDS

CASING RECORD

FORMATION	CONTENT	FROM	TO	SIZE	PUT IN	PULLED OUT
Surface			202'	8 5/8		left in

Describe in detail the manner in which the well was plugged, indicating where the mud fluid was placed and the method or methods used in introducing it into the hole. If cement or other plugs were used, state the character of same and depth placed, from feet to feet for each plug set.

10 sacks cement in bottom of Surface Pipe

Hole filled with Heavy Mud

5 SKS cement in top of Surface Pipe

RECEIVED  
STATE CORPORATION COMMISSION

JAN 31 1962

CONSERVATION DIVISION  
Kansas

01-31-1962

(If additional description is necessary, use BACK of this sheet)

Name of Plugging Contractor Kimbark Exploration Company

Address 201 University Blvd., Denver, Colorado


STATE OF Colorado, COUNTY OF Denver, ss. O. H. Shankland

(employee of owner) or (owner or operator) of the above-described well, being first duly sworn on oath, says: That I have knowledge of the facts, statements, and matters herein contained and the log of the above-described well as filed and that the same are true and correct. So help me God.

(Signature) O. H. Shankland

320 Peter Club Bldg Denver Colo (Address)

SUBSCRIBED AND SWORN TO before me this 30th day of January, 1962

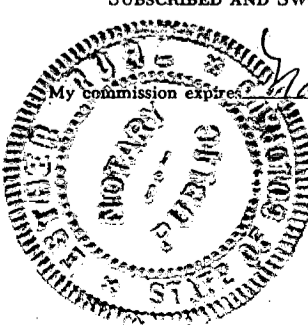

E. Schuchert Notary Public.

15-065 - 03504-00-00

RICHMEIER #1 WELL

Location: C SE SW Section 36  
T-9-S, R-25-W  
Graham County, Kansas

Spudded: 11/27/61  
Completed: 12/6/61

Owner: J. A. Terteling and Sons  
Petroleum Club Building  
Denver 2, Colorado

Contractor: Kimbark Exploration Co.  
201 University Blvd.  
Denver 6, Colorado

Surface Casing: 8 5/8" surface casing at 202' with 150 sacks cement.

Oil String: None

LOG

Figures indicate bottom of formation

181	Clay-Sand-Shale
207	Shale
298	Shale
830	Shale
1,415	Shale-Sand
1,775	Shale
2,136	Shale
2,290	Anhydrite-Shale
2,520	Shale Lime
2,620	Shale-Lime
2,765	Lime-Shale
2,875	Shale-Lime
2,950	Lime
3,130	Lime
3,223	Lime
3,280	Lime
3,506	Lime
3,600	Lime
3,670	Lime-Shale
3,753	Lime
3,865	Lime
3,910	Lime
4,015	Lime
4,055	Lime
4,055	Rotary Total Depth

**RECEIVED**  
STATE CORPORATION COMMISSION

JAN 31 1962  
01-31-1962  
CONSERVATION DIVISION  
Wichita, Kansas

**RECEIVED**  
JAN 24 1962  
DENVER

The undersigned, W. K. Arbuckle, President of Kimbark Exploration, hereby certifies that the above is a true and correct log of the formations encountered in drilling the Richmeier #1 as shown in the daily drilling reports.

KIMBARK EXPLORATION COMPANY


*W. K. Arbuckle*

W. K. Arbuckle, President

STATE OF COLORADO ) ss  
CITY & COUNTY OF DENVER)

Be it remembered that on this 22nd day of January A.D. 1962, before me, Marilyn A. Rehm, a Notary Public, personally appeared W. K. Arbuckle; President of Kimbark Exploration Company, a Colorado Corporation, who is personally known to me and known to me to be the President of said Corporation, and the same person who executed the foregoing instrument, and he duly acknowledged the execution of the same for and on behalf of and as the act and deed of said Corporation.

WITNESS my hand and official seal:  
My Commission Expires November 15, 1964

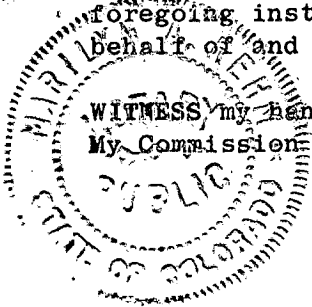

*Marilyn A. Rehm*  
Notary Public