

15-065-20422-00-00

STATE OF KANSAS
STATE CORPORATION COMMISSION

Form CP-4

Give All Information Completely
Make Required Affidavit
Mail or Deliver Report to:
Conservation Division
State Corporation Commission
212 No. Market
Wichita, Kansas 67202

WELL PLUGGING RECORD

Graham County, Sec. 36 Twp. 9 Rge. 25 (E) W (W)

Location as "NE/CNW/SW" or footage from lines. SE NE NE

Lease Owner Thunderbird Drilling, Inc.

Lease Name Clark B Well No. 1

Office Address 4328 E. Kellogg, Wichita, Kansas 67202

Character of Well (completed as Oil, Gas or Dry Hole) Dry Hole

Date well completed 3-23 1971

Application for plugging filed 3-23 1971

Application for plugging approved 3-23 1971

Plugging commenced 3-23 1971

Plugging completed 3-23 1971

Reason for abandonment of well or producing formation Dry Hole


If a producing well is abandoned, date of last production 19

Was permission obtained from the Conservation Division or its agents before plugging was commenced? Yes

Name of Conservation Agent who supervised plugging of this well Bill Nichols

Producing formation _____ Depth to top _____ Bottom _____ Total Depth of Well _____ Feet

Show depth and thickness of all water, oil and gas formations.

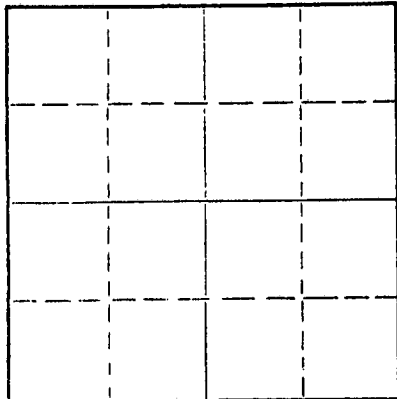

Locate well correctly on above Section Plat

OIL, GAS OR WATER RECORDS

CASING RECORD

FORMATION	CONTENT	FROM	TO	SIZE	PUT IN	PULLED OUT
Surface Pipe				8 5/8"	256'	

Describe in detail the manner in which the well was plugged, indicating where the mud fluid was placed and the method or methods used in introducing it into the hole. If cement or other plugs were used, state the character of same and depth placed, from _____ feet to _____ feet for each plug set.

1st plug was set at 1250' with 100 cu. ft. cement
2nd plug was set at 1275' with 25' cu. ft. cement
3rd plug was set at 40' with 10 cu. ft. cement

RECEIVED
STATE CORPORATION COMMISSION
CONSERVATION DIVISION
Wichita, Kansas
MAR 25 1971
63-25-1971

(If additional description is necessary, use BACK of this sheet)

Name of Plugging Contractor Dreiling Oil, Inc.
Address Victoria, Kansas 67671

STATE OF KANSAS, COUNTY OF ELLIS, ss.

I, Leo F. Dreiling, Pres. of Drlg. Contrc. of the above-described well, being first duly sworn on oath, says: That I have knowledge of the facts, statements, and matters herein contained and the log of the above-described well as filed and that the same are true and correct. So help me God.

(Signature) Leo F. Dreiling

LEO F. DREILING, ROUTE 2, VICTORIA, KANSAS 67671


(Address)

Subscribed and Sworn to before me this 24th day of March, 1971

Patty Dreiling
PATTY DREILING

Notary Public.

My commission expires January 13, 1975

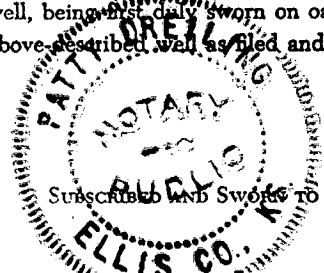

DREILING OIL, INC.

Victoria, Kansas 67671

15-065-20422-00-00

Thunderbird Drilling, Inc. WELL LOG

Company 4328 E. Kellogg
 Wichita, Kansas 67202

Farm Clark B No. 1

Total Depth 4110'

Comm. 3-16-71 Comp. 3-23-71

Contractor Dreiling Oil, Inc.
 Victoria, Kansas 67671

Sec. 36 Twp. 9 Rng. 25

Location SE NE NE

County Grham

Elevation: 2542' K. B.

 2539' D. F.

 2537' G. R.

Casing Record

Cement Record

Production:

256' - 8 5/8"

175 sacks cement

D & A

Figures Indicate Bottom of Formations

0'	150'	Top Soil, Sand & Gravel
150'	170'	Blue Shale
170'	256'	Shale
256'	1240'	Shale
1240'	1750'	Shale
1750'	1954'	Sand
1954'	2110'	Red Bed & Shale
2110'	2195'	Shale
2195'	2236'	Anhydrite
2236'	2490'	Anhydrite
2490'	2795'	Shale
2795'	2840'	Shale
2840'	2995'	Shale & Lime
2995'	3275'	Lime & Shale
3275'	3398'	Shale & Lime
3398'	3620'	Shale & Lime
3620'	3835'	Lime
3835'	3885'	Lime
3885'	3895'	Lime
3895'	3905'	Lime
3905'	3920'	Lime
3920'	3960'	Lime
3960'	4036'	Lime
4036'	4060'	Lime
4060'	4085'	Lime
4085'	4110'	Lime
4110'	T.D.	


STATE OF KANSAS)
)ss
 COUNTY OF ELLIS)

RECEIVED
 STATE CORPORATION COMMISSION
 MAR 25 1971
 CONSERVATION DIVISION
 Wichita, Kansas

I, Leo F. Dreiling, of Dreiling Oil, Inc., upon oath states that the above and foregoing is a true and correct copy from the Daily Drilling Report from your Clark B #1.

Leo F. Dreiling
 LEO F. DREILING

Subscribed and sworn to before me this 24th day of March, 1971.

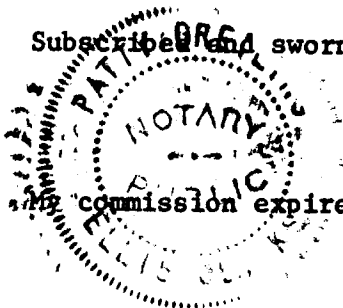

Patty Dreiling
 PATTY DREILING NOTARY PUBLIC

My commission expires: January 13, 1975