

15-065-21840-00-00

STATE OF KANSAS
STATE CORPORATION COMMISSION

WELL PLUGGING RECORD

Give All Information Completely
Make Required Affidavit
Mail or Deliver Report to
Conservation Division
State Corporation Comm.
245 North Water
Wichita, KS 67202

Graham County. Sec. 36 Twp. 9S Rge. 25 EE/W
Location as "NE/CNW $\frac{1}{2}$ SW $\frac{1}{2}$ " or footage from lines NW SE NE

Lease Owner Abraxas Petroleum Corporation
Lease Name Clark Well No. #1


Office Address 1100 NE Loop 410, Box 17485, San Antonio, Tex
Character of Well (Completed as Oil, Gas or Dry Hole) Dry Hole

Date Well completed 11-3-83 19
Application for plugging filed 11-3-83 19
Application for plugging approved 11-3-83 19
Plugging commenced 11-3-83 19
Plugging completed 11-3-83 19

Reason for abandonment of well or producing formation Commercial quantities of oil not found
If a producing well is abandoned, date of last production 19

Was permission obtained from the Conservation Division or its agents before plugging was commenced? Yes

Name of Conservation Agent who supervised plugging of this well Carl Goodrow
Producing formation _____ Depth to top _____ Bottom _____ Total Depth of Well 4130'
Show depth and thickness of all water, oil and gas formations.

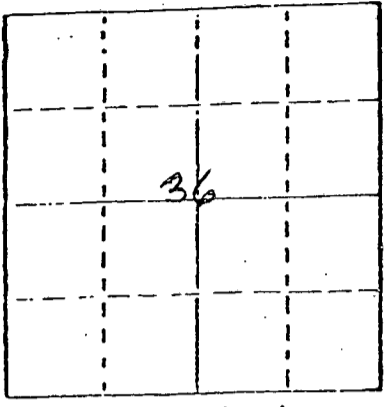

Locate well correctly on above Section Plat

OIL, GAS OR WATER RECORDS

CASING RECORD

FORMATION	CONTENT	FROM	TO	SIZE	PUT IN	PULLED OUT
				8 5/8"	267'	None

Describe in detail the manner in which the well was plugged, indicating where the mud fluid was placed and the method or methods used in introducing it into the hold. If cement or other plugs were used, state the character of same and depth placed, from _____ feet to _____ feet for each plug set.

- Plug @ 2200' w/20 sx.
- Plug @ 1300' w/100 sx.
- Plug @ 270' w/40 sx.
- Plug @ 40' w/10 sx.
- Rat Hole 10 sx.

(If additional description is necessary, use BACK of this sheet)

Name of Plugging Contractor Rains & Williamson Oil Co., Inc.

STATE OF Kansas COUNTY OF Sedgwick, ss.
Wilson Rains, President of Rains & Williamson Oil Co., (Employee of owner) or (owner or operator) of the above-described well, being first duly sworn on oath, says: That I have knowledge of the facts, statements, and matters herein contained and the log of the above-described well as filed and that the same are true and correct. So help me God.

(Signature) Wilson Rains
435 Page Court, 220 W. Douglas, Wichita, KS 67202
(Address)

SUBSCRIBED AND SWORN TO before me this 7 day of November, 1983

Juanita M. Green
Juanita M. Green Notary Public.



RECEIVED
STATE CORPORATION COMMISSION

JAN 09 1984
01-09-1984
CONSERVATION DIVISION
Wichita, Kansas