


15-179-00068-00-00

WELL PLUGGING RECORD

Give All Information Completely  
Make Required Affidavit  
Mail or Deliver Report to:  
Conservation Division  
State Corporation Commission  
211 No. Broadway  
Wichita, Kansas

NORTH

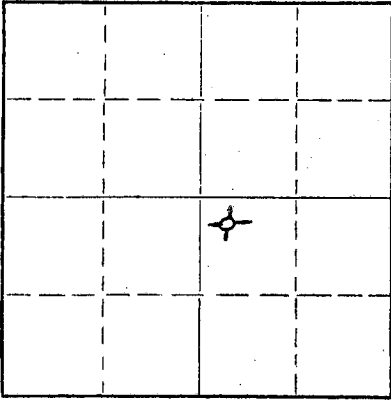

Locate well correctly on above Section Plat

Sheridan County. Sec. 1 Twp. 9S Rge. 26 (W)  
Location as "NE/CNW/SW" or footage from lines NW NW SE  
Lease Owner Peel-Hardman Oil Operators  
Lease Name Davis Well No. 1  
Office Address R. R. #3, Box 144B, Wichita 15, Kansas  
Character of Well (completed as Oil, Gas or Dry Hole) Dry Hole  
Date well completed 12-6 19 58  
Application for plugging filed 12-6 19 58  
Application for plugging approved 12-6 19 58  
Plugging commenced 12-6 19 58  
Plugging completed 12-6 19 58  
Reason for abandonment of well or producing formation Dry Hole

If a producing well is abandoned, date of last production \_\_\_\_\_ 19\_\_\_\_  
Was permission obtained from the Conservation Division or its agents before plugging was commenced? Yes

Name of Conservation Agent who supervised plugging of this well A. D. Fabricius  
Producing formation \_\_\_\_\_ Depth to top \_\_\_\_\_ Bottom \_\_\_\_\_ Total Depth of Well 4060 Feet  
Show depth and thickness of all water, oil and gas formations.

OIL, GAS OR WATER RECORDS

CASING RECORD

FORMATION	CONTENT	FROM	TO	SIZE	PUT IN	PULLED OUT
		0	200'	8 5/8"	200	None

Describe in detail the manner in which the well was plugged, indicating where the mud fluid was placed and the method or methods used in introducing it into the hole. If cement or other plugs were used, state the character of same and depth placed, from \_\_\_\_\_ feet to \_\_\_\_\_ feet for each plug set.

From 4060' to 601 1/2' - Heavy Rotary Mud  
" 601 1/2' to 600' - Howco Plug  
" 600' to 538' - 20 sacks Cement  
" 538' to 196 1/2' - Heavy Rotary Mud  
" 196 1/2' to 195' - Howco Plug  
" 195' to 133' - 20 sacks Cement and 1/2 sack Hulls  
" 133' to 41 1/2' - Heavy Rotary Mud  
" 41 1/2' to 40' - Howco Plug  
" 40' to 6' - 10 sacks Cement and 1/2 sack Hulls  
" 6' to surface - Cellar

RECEIVED  
STATE CORPORATION COMMISSION  
DEC 12 1958  
12-17-1958  
CONSERVATION DIVISION  
Wichita, Kansas

(If additional description is necessary, use BACK of this sheet)

Name of Plugging Contractor \_\_\_\_\_  
Address \_\_\_\_\_

STATE OF Kansas, COUNTY OF Sedgwick, ss.  
William Herbert (employee of owner) or owner/agent of the above-described well, being first duly sworn on oath, says: That I have knowledge of the facts, statements, and matters herein contained and the log of the above-described well as filed and that the same are true and correct. So help me God.

(Signature) William Herbert  
R. R. #3, Box 144B, Wichita 15, Kansas  
(Address)

SUBSCRIBED AND SWORN to before me this 11th day of December, 19 58  
Maniam M. Herbert  
Notary Public.

My commission expires March 4, 1962

PLUGGING  
FILE SEC. 1 T. 9 R. 26W  
BOOK PAGE 3 LINE 36

15-179-00068-00-00

DRILLER'S LOG

Company: Peel-Hardman Oil Operators

Location: NW NW SE  
Sec 1-Twp 9S-Rge 26W

Farm: Davis Well No. 1

County: Sheridan,  
Kansas

Total Depth: 4060'

Comm.: 11-25-58 Comp.: 12-6-58

Elevation:

Contractor: Glenn W. Peel Drilling Company

Production: Dry

Casing: 8 5/8" @ 200' Cem.

Figures below indicate bottom of formations

Surface Clay and sand	0	200'
Shale		1240
Sand		1400
Shale and sand		1645
Shale		1770
Red Bed		2020
Shale		2237
Anhydrite		2280
Shale and shells		2390
Shale and lime		2490
Shale		2665
Shale and shells		2900
Shale and lime		3015
Lime		3080
Shale		3215
Lime		3620
Shale and lime		3700
Lime		4060
Total Depth		4060

This is to certify that the above information is to the best of my knowledge true and correct.

GLENN W. PEEL DRILLING COMPANY

BY: *Glenn W. Peel*

SUBSCRIBED AND SWORN TO before me this 11<sup>th</sup> day of December, 1958.

My commission expires March 4, 1962.

*Marion M. Herbert*  
Notary Public

RECEIVED  
STATE CORPORATION COMMISSION

DEC 12 1958

CONSERVATION DIV.  
WICHITA

12-12-1958

PLUGGING  
FILE SEC 1 T 9 R 26W  
BOOK PAGE 3 LINE 36