

CARD MUST BE TYPED

State of Kansas
NOTICE OF INTENTION TO DRILL

CARD MUST BE SIGNED

(see rules on reverse side)

Starting Date: 5 10 85
month day year

API Number 15- 179-20,804-00-00

OPERATOR: License # 5135

SE. NW. NW. Sec. 2. Twp. 9. S, Rge. 26. East
(location) West

Name John O. Farmer, Inc.

Address P.O. Box 352

City/State/Zip Russell, KS 67665

Contact Person Sam Farmer

Phone (913) 483-3144

4290 Ft North from Southeast Corner of Section

4290 Ft West from Southeast Corner of Section

(Note: Locate well on Section Plat on reverse side)

CONTRACTOR: License # 5135

Name John O. Farmer, Inc.

City/State Russell, KS 67665

Nearest lease or unit boundary line 990 feet.

County Sheridan

Lease Name Simon Well# 1

Domestic well within 330 feet: yes no

Municipal well within one mile: yes no

Well Drilled For: Well Class: Type Equipment:

Oil Swd Infield Mud Rotary

Gas Inj Pool Ext. Air Rotary

OWWO Expl Wildcat Cable

Depth to Bottom of fresh water 100-150 mhc feet

Lowest usable water formation Dakota feet

Depth to Bottom of usable water 1500 feet

Surface pipe by Alternate: ~~429~~ 2

Surface pipe to be set 200 feet

Conductor pipe if any required none feet

Ground surface elevation 2550 Est. feet MSI.

This Authorization Expires 9-25-85

Approved By 3-25-85 *LC*

If OWWO: old well info as follows:

Operator

Well Name

Comp Date Old Total Depth

Projected Total Depth 4000 feet

Projected Formation at TD B/KC

Expected Producing Formations Lansing

I certify that we will comply with K.S.A. 55-101, et seq., plus eventually plugging hole to K.C.C. specifications.

Date 3-22-85

Signature of Operator or Agent *John O. Farmer, Jr.*

Title Vice-president

MHC/KONE 3-25-85

Must be filed with the K.C.C. five (5) days prior to commencing well
This card void if drilling not started within six (6) months of date received by K.C.C.


RECEIVED
STATE CORPORATION COMMISSION

A Regular Section of Land
1 Mile = 5,280 Ft.

MAR 25 1985
03-25-1985
CONSERVATION DIVISION
Wichita, Kansas

Important procedures to follow :

1. Notify District office before setting surface casing.
2. Set surface casing by circulating cement to the top.
3. File completion forms ACO-1 with K.C.C. within 90 days of well completion, following instructions on ACO-1, side 1, and including copies of wireline logs.
4. Notify District office 48 hours prior to old well workover or re-entry.
5. Prior to plugging, prepare a plugging plan, then obtain agreement from the appropriate district office for an approved plugging plan.
6. Submit plugging report (CP-4) to K.C.C. after plugging is completed.
7. Obtain an approved injection docket number before disposing of salt water.
8. Notify K.C.C. within 10 days when injection commences or terminates.
9. If an alternate 2 completion, cement in the production pipe from below any usable water to surface within 120 days of spud date.

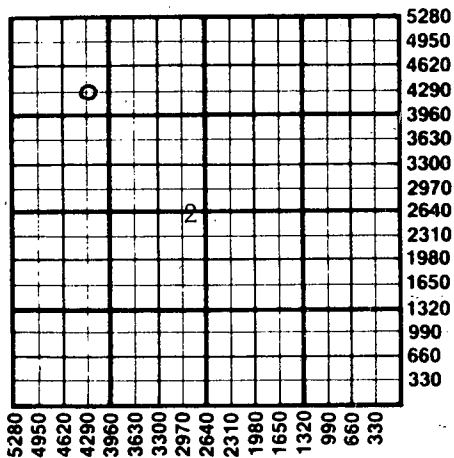

State Corporation Commission of Kansas
Conservation Division
200 Colorado Derby Building
Wichita, Kansas 67202
(316) 263-3238