

CARD MUST BE TYPED

State of Kansas
NOTICE OF INTENTION TO DRILL

CARD MUST BE SIGNED

(see rules on reverse side)

Starting Date: 8 20 85
month day year

API Number 15- 179-20,840-00-00

OPERATOR: License # 5151
Name Great Pet Co Inc
Address 300 Sutton Place
City/State/Zip Wichita, KS 67202
Contact Person Jim Thatcher
Phone 316-265-3351

..... C NW SW Sec 20 Twp . 9 . S, Rge . 27 .
(location) East West

..... 1980 Ft North from Southeast Corner of Section
..... 4620 Ft West from Southeast Corner of Section
(Note: Locate well on Section Plat on reverse side)

CONTRACTOR: License # 5302
Name Red Tiger Drlg. Co.
City/State Wichita, KS 67202

Nearest lease or unit boundary line 660 feet.
County Sheridan
Lease Name Kennedy Well# 1-20

Well Drilled For: **Well Class:** **Type Equipment:**
 Oil Swd Infield Mud Rotary
 Gas Inj Pool Ext. Air Rotary
 OWWO Expl Wildcat Cable

Domestic well within 330 feet : yes no
Municipal well within one mile : yes no

If OWWO: old well info as follows:
Operator
Well Name
Comp Date Old Total Depth
Projected Total Depth 4200 feet
Projected Formation at TD Base LKC
Expected Producing Formations LKC

Depth to Bottom of fresh water 150 feet
Lowest usable water formation Dakota
Depth to Bottom of usable water 1100-1500 feet
Surface pipe by Alternate : 1 2
Surface pipe to be set 320 feet
Conductor pipe if any required none feet
Ground surface elevation unknown feet MSL
This Authorization Expires 1-30-86

I certify that we will comply with K.S.A. 55-101, et seq., plus eventually plugging hole to K.C.C. specifications.

Approved By Jim Thatcher
Production Engineer

Date 7-29-85 Signature of Operator or Agent Title

Must be filed with the K.C.C. five (5) days prior to commencing well
 This card void if drilling not started within six (6) months of date received by K.C.C.

RECEIVED
 STATE CORPORATION COMMISSION


07-30-85

Important procedures to follow:

A Regular Section of Land
 1 Mile = 5,280 Ft.

JUL 30 1985

CONSERVATION DIVISION
 Wichita, Kansas

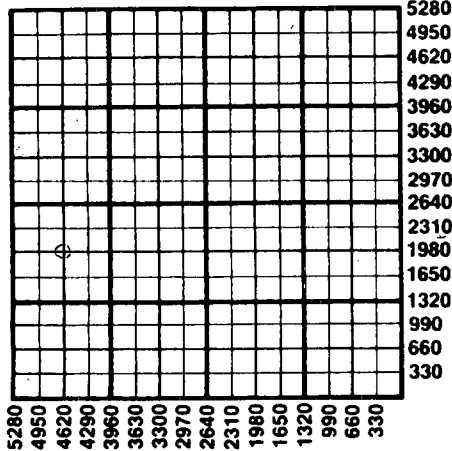

1. Notify District office before setting surface casing.
2. Set surface casing by circulating cement to the top.
3. File completion forms ACO-1 with K.C.C. within 90 days of well completion, following instructions on ACO-1, side 1, and including copies of wireline logs.
4. Notify District office 48 hours prior to old well workover or re-entry.
5. Prior to plugging, prepare a plugging plan, then obtain agreement from the appropriate district office for an approved plugging plan.
6. Submit plugging report (CP-4) to K.C.C. after plugging is completed.
7. Obtain an approved injection docket number before disposing of salt water.
8. Notify K.C.C. within 10 days when injection commences or terminates.
9. If an alternate 2 completion, cement in the production pipe from below any usable water to surface within 120 days of spud date.

State Corporation Commission of Kansas
 Conservation Division
 200 Colorado Derby Building
 Wichita, Kansas 67202
 (316) 263-3238