

CARD MUST BE TYPED

NOTICE OF INTENTION TO DRILL

State of Kansas
(see rules on reverse side)

CARD MUST BE SIGNED

Starting Date: October 26 1984
month day year

API Number 15- 179-20,772-00-00

OPERATOR: License # 5273
Name Kiowa Exploration Company
Address 110 So. Main, Suite #510
City/State/Zip Wichita, Kansas 67202
Contact Person J. Corry Tinsmon
Phone 267-0228

NE. SW. NE Sec 14 Twp 9 S Rge 28 East
(location) West

3630 Ft North from Southeast Corner of Section
1650 Ft West from Southeast Corner of Section
(Note: Locate well on Section Plat on reverse side)

CONTRACTOR: License # 5135
Name John O. Farmer, Inc.
City/State Russell, Kansas

Nearest lease or unit boundary line 990 feet.
County Sheridan
Lease Name Schwarzenberger Well# 1

Well Drilled For: Well Class: Type Equipment:
 Oil Swd Infield Mud Rotary
 Gas Inj Pool Ext. Air Rotary
 OWWO Expl Wildcat Cable

Domestic well within 330 feet: yes no
Municipal well within one mile: yes no

If OWWO: old well info as follows:

Operator
Well Name
Comp Date Old Total Depth
Projected Total Depth 4100 feet
Projected Formation at TD Base/Kansas City
Expected Producing Formations Kansas City

Depth to Bottom of fresh water 200 feet
Lowest usable water formation Dakota
Depth to Bottom of usable water 2200 1525 feet
Surface pipe by Alternate: 1 2 275
Surface pipe to be set feet
Conductor pipe if any required N/A feet
Ground surface elevation 2758 feet MSL
This Authorization Expires 4-22-85
Approved By 10-22-84 *RC*

I certify that we will comply with K.S.A. 55-101, et seq., plus eventually plugging hole to K.C.C. specifications.

Date 10/18/84 Signature of Operator or Agent *J. Corry Tinsmon*


Title Managing Partner

m HC/MOHE 10/22/84 Form C-1 4/84

Must be filed with the K.C.C. five (5) days prior to commencing well
This card void if drilling not started within six (6) months of date received by K.C.C.

Important procedures to follow :

**A Regular Section of Land
1 Mile = 5,280 Ft.**

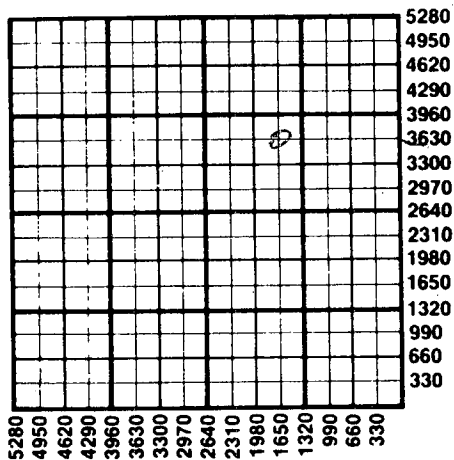

1. Notify District office before setting surface casing.
 2. Set surface casing by circulating cement to the top.
 3. File completion forms ACO-1 with K.C.C. within 90 days of well completion, following instructions on ACO-1, side 1, and including copies of wireline logs.
 4. Notify District office 48 hours prior to old well workover or re-entry.
 5. Prior to plugging, prepare a plugging plan, then obtain agreement from the appropriate district office for an approved plugging plan.
 6. Submit plugging report (CP-4) to K.C.C. after plugging is completed.
 7. Obtain an approved injection docket number before disposing of salt water.
 8. Notify K.C.C. within 10 days when injection commences or terminates.
 9. Alternate 2 completion, cement in the production pipe from below
- STATE CORPORATION COMMISSION

RECEIVED
STATE CORPORATION COMMISSION

OCT 22 1984
10-22-1984
CONSERVATION DIVISION
Wichita, Kansas

State Corporation Commission of Kansas
Conservation Division
200 Colorado Derby Building
Wichita, Kansas 67202
(316) 263-3238