

CARD MUST BE TYPED

State of Kansas
NOTICE OF INTENTION TO DRILL

CARD MUST BE SIGNED

(see rules on reverse side)

Starting Date: 6 7 85
month day year

API Number IS- 179-20,827-00-00

OPERATOR: License # 5140
Name Frontier Oil Company
Address 1720 Kansas State Bank Bldg.
City/State/Zip Wichita, Kansas 67202
Contact Person George Angle
Phone 263-1201

S/2 S/2 NE 30 9S 28W East
Sec Twp S, Rge West

(location)
2970 Ft North from Southeast Corner of Section
1320 Ft West from Southeast Corner of Section
(Note: Locate well on Section Plat on reverse side)

CONTRACTOR: License # 5302
Name Red Tiger Drilling Co.
City/State Wichita, Kansas 67202

Nearest lease or unit boundary line ... 330 feet.
County ... Sheridan

Lease Name ... Adams Well# ... 2

Well Drilled For: Well Class: Type Equipment:
 Oil Swd Infield Mud Rotary
 Gas Inj Pool Ext. Air Rotary
 OWWO Expl Wildcat Cable

Domestic well within 330 feet : yes no
Municipal well within one mile : yes no

If OWWO: old well info as follows:
Operator
Well Name
Comp Date Old Total Depth
Projected Total Depth 4200 feet
Projected Formation at TD Base Kansas City
Expected Producing Formations Base Kansas City

Depth to Bottom of fresh water 200 feet
Lowest usable water formation ... Dakota
Depth to Bottom of usable water 1500 feet
Surface pipe by Alternate : 1 2
Surface pipe to be set ... 200 ... 250 mHE feet
Conductor pipe if any required none feet
Ground surface elevation feet MSL.

This Authorization Expires 12-4-85
Approved By 6-4-85 [Signature]

I certify that we will comply with K.S.A. 55-101, et seq., plus eventually plugging hole to K.S.A. specifications

Date 6/4/85 Signature of Operator or Agent


[Signature: George A. Angle]

Owner title
MHC/10HE 6-4-85

RECEIVED
STATE CORPORATION COMMISSION

Must be filed with the K.C.C. five (5) days prior to commencing well
This card void if drilling not started within six (6) months of date received by K.C.C.

JUN 4 1985
00-04-1985
CONSERVATION DIVISION
A Regular Section of Land
Wichita, Kansas
1 Mile = 5,280 Ft.

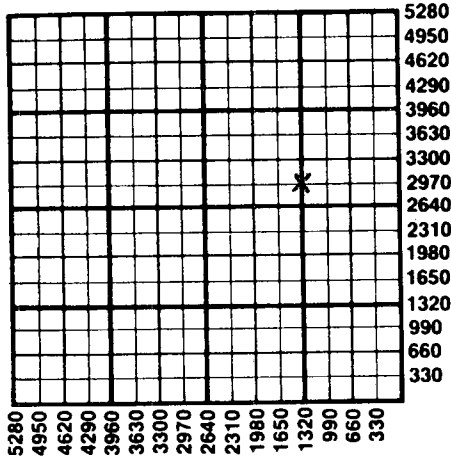

Important procedures to follow:

1. Notify District office before setting surface casing.
2. Set surface casing by circulating cement to the top.
3. File completion forms ACO-1 with K.C.C. within 90 days of well completion, following instructions on ACO-1, side 1, and including copies of wireline logs.
4. Notify District office 48 hours prior to old well workover or re-entry.
5. Prior to plugging, prepare a plugging plan, then obtain agreement from the appropriate district office for an approved plugging plan.
6. Submit plugging report (CP-4) to K.C.C. after plugging is completed.
7. Obtain an approved injection docket number before disposing of salt water.
8. Notify K.C.C. within 10 days when injection commences or terminates.
9. If an alternate 2 completion, cement in the production pipe from below any usable water to surface within 120 days of spud date.

**State Corporation Commission of Kansas
Conservation Division
200 Colorado Derby Building
Wichita, Kansas 67202
(316) 263-3238**