

EFFECTIVE DATE: 11-27-89

State of Kansas

NOTICE OF INTENTION TO DRILL

Must be approved by the K.C.C. five (5) days prior to commencing well

Expected Spud Date ..Dec. 1..1989.....
month day year

C.... NE. NW. Sec 14.. Twp 9.... S, Rg 28.. X East West

5005
OPERATOR: License #
Name: ..Sunburst Exploration Company, Inc......
Address: 125 N. Emporia... Suite 112.....
City/State/Zip: ..Wichita, KS 67202.....
Contact Person: ..Ron Liron.....
Phone: ..(316) 262-3041.....

4620
..... feet from South line of Section
.....3300..... feet from East line of Section
(Note: Locate well on Section Plat Below)

8241
CONTRACTOR: License #:
Name: Emphasis Oil Operations.....

County: Sheridan
Lease Name: R. Scherzenberger Well # 1
Field Name: ..UNKNOWN.....
Is this a Prorated Field? ..X yes no
Target Formation(s): ..Kansas City.....
Nearest lease or unit boundary: ..660.....
Ground Surface Elevation: ..2755..... feet MSL
Domestic well within 330 feet: yes ..X no
Municipal well within one mile: yes ..X no
Depth to bottom of fresh water: ..150 210'.....
Depth to bottom of usable water: ..1380 1550'.....
Surface Pipe by Alternate: 1 ..X 2
Length of Surface Pipe Planned to be set: 280.....
Length of Conductor pipe required:0.....
Projected Total Depth:4150.....
Formation at Total Depth: ..Kansas City.....
Water Source for Drilling Operations:
... well farm pond X... other
DWR Permit #:
Will Cores Be Taken?: yes ..X no
If yes, proposed zone: ..Z.....

Well Drilled For: Well Class: Type Equipment:
X Oil ... Inj ... Infield X Mud Rotary
... Gas ... Storage ... Pool-Ext: ... Air Rotary
... OWO ... Disposal X Wildcat ... Cable
... Seismic; ... # of Holes

If OWO: old well information as follows:
Operator:
Well Name:
Comp. Date: Old Total Depth

Directional, Deviated or Horizontal wellbore? yes ..X no
If yes, total depth location:
Prorated: Solomon Fork: LKC; oil

AFFIDAVIT


The undersigned hereby affirms that the drilling, completion and eventual plugging of this well will comply with K.S.A. 55-101, et. seq.

It is agreed that the following minimum requirements will be met:

1. The appropriate district office shall be notified before setting surface pipe;
2. The minimum amount of surface pipe as specified above shall be set by circulating cement to the top; in all cases surface pipe shall be set through all unconsolidated materials plus a minimum of 20 feet into the underlying formation;
3. If the well is dry, a plugging proposal shall be submitted to the district office. An agreement between the operator and the district office on plug length and placement is necessary prior to plugging;
4. The appropriate district office will be notified before well is either plugged or production casing is cemented in;
5. If an Alternate II completion, production pipe shall be cemented from below any usable water to surface within 120 days of spud-date. In all cases, notify district office prior to any cementing.

I hereby certify that the statements made herein are true and to the best of my knowledge and belief.

Date: Nov. 18, 1989. Signature of Operator or Agent: Ronald L Iron..... Title: Vice President.....

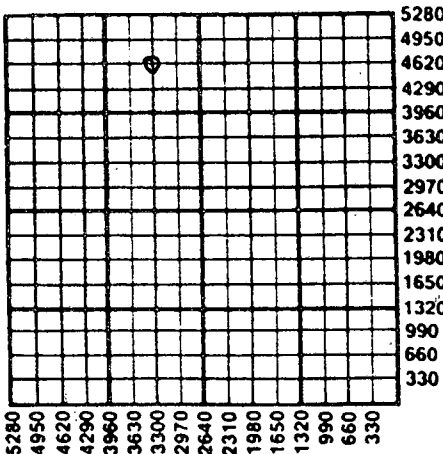

FOR KCC USE:

API # 15- 179-20950-00-00

Conductor pipe required NONE feet

Minimum surface pipe required 260' feet per Alt. X(2)

Approved by: DPW 11-22-89

EFFECTIVE DATE: 11-27-89

This authorization expires: 5-22-90

This authorization void if drilling not started within 6 months of effective date.)

Spud date: _____ Agent: _____

RECEIVED
STATE CONSERVATION DIVISION
NOV 20 1989
11-20-89
CONSERVATION DIVISION
Wichita, Kansas

14
9
28W

REMEMBER TO:

- File Drill Pit Application (form CDP-1) with Intent to Drill;
- File Completion Form ACO-1 within 120 days of spud date;
- File acreage attribution plat according to field proration orders;
- Notify appropriate district office 48 hours prior to workover or re-entry;
- Submit plugging report (CP-4) after plugging is completed;
- Obtain written approval before disposing or injecting salt water.