

CARD MUST BE TYPED

State of Kansas
NOTICE OF INTENTION TO DRILL

CARD MUST BE SIGNED

(see rules on reverse side)

Starting Date: 01 15 85
month day year

API Number 15-

193-20,342-00-00

OPERATOR: License # 7506

Name First Energy Corporation

Address 16701 Greenspoint Park Dr., Suite 200

City/State/Zip Houston, TX 77060

Contact Person Bill Dean

Phone 713-847-5755

CONTRACTOR: License # 6033

Name Murfin Drilling Company

City/State Wichita, KS 67202

Well Drilled For: Well Class: Type Equipment:

- Oil Swd Infield Mud Rotary
- Gas Inj Pool Ext. Air Rotary
- OWWO Expl Wildcat Cable

If OWWO: old well info as follows:

Operator

Well Name

Comp Date Old Total Depth

Projected Total Depth 4900' feet

Projected Formation at TD MISS.

Expected Producing Formations LKC

C...SW .SE. SW Sec 30.. Twp .9.. S, Rge 34.. East
(location) West

330 Ft North from Southeast Corner of Section

3630 Ft West from Southeast Corner of Section

(Note: Locate well on Section Plat on reverse side)

Nearest lease or unit boundary line 330 feet.

County Thomas

Lease Name Ulrich Well# 38-30...

Domestic well within 330 feet: yes no

Municipal well within one mile: yes no

Depth to Bottom of fresh water 150 200 m H₂O feet

Lowest usable water formation Unconsolidated Dakota

Depth to Bottom of usable water 1725 1800 feet

Surface pipe by Alternate: 1 2

Surface pipe to be set 350 feet

Conductor pipe if any required N/A feet

Ground surface elevation feet MSL

This Authorization Expires 7-10-85

Approved By 1-10-85 *PC*

I certify that we will comply with K.S.A. 55-101, et seq., plus eventually plugging hole to K.C.C. specifications.

Date 1-10-85

Signature of Operator or Agent

Jack E. Goss, Agent for Operator

Title

Ass't. Drilling Manager

Form C-1 4/84

MHC/KDHE 1-10-85


RECEIVED
STATE CORPORATION COMMISSION

01-10-1985
JAN 10 1985

Must be filed with the K.C.C. five (5) days prior to commencing well
This card void if drilling not started within six (6) months of date received by K.C.C.

CONSERVATION DIVISION
Wichita

A Regular Section of Land
1 Mile = 5,280 Ft.

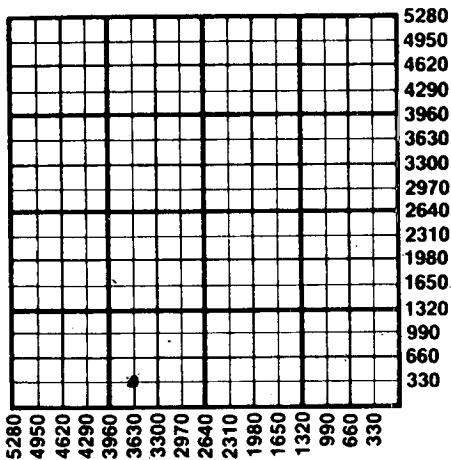

Important procedures to follow:

1. Notify District office before setting surface casing.
2. Set surface casing by circulating cement to the top.
3. File completion forms ACO-1 with K.C.C. within 90 days of well completion, following instructions on ACO-1, side 1, and including copies of wireline logs.
4. Notify District office 48 hours prior to old well workover or re-entry.
5. Prior to plugging, prepare a plugging plan, then obtain agreement from the appropriate district office for an approved plugging plan.
6. Submit plugging report (CP-4) to K.C.C. after plugging is completed.
7. Obtain an approved injection docket number before disposing of salt water.
8. Notify K.C.C. within 10 days when injection commences or terminates.
9. If an alternate 2 completion, cement in the production pipe from below any usable water to surface within 120 days of spud date.

State Corporation Commission of Kansas
Conservation Division
200 Colorado Derby Building
Wichita, Kansas 67202
(316) 263-3238