

NOTICE OF INTENTION TO DRILL

(see rules on reverse side)

Starting Date ... February ... 10 ... 1987 ... month day year

API Number 15- 193-20,430-00-00

OPERATOR: License # 5181 Name SLAWSON, DONALD C. Address 200 Douglas Building City/State/Zip Wichita, Kansas 67202 Contact Person Bill Horigan Phone (316) 263-3201

SW NW SE Sec. 23 Twp. 9 S, Rg. 33 West 1640' Ft. from South Line of Section 2390' Ft. from East Line of Section

(Note: Locate well on Section Plat on reverse side)

CONTRACTOR: License # 5657 Name Slawson Drilling Co. City/State Wichita, Kansas

Nearest lease or unit boundary line ... 330' feet County Thomas

Lease Name Hansen 'U' Well # 1

Ground surface elevation ... 3115' GR. (Seis.) feet MSL

Domestic well within 330 feet: yes no

Municipal well within one mile: yes no

Depth to bottom of fresh water ... 100' 250'

Depth to bottom of usable water 1750'

Surface pipe by Alternate: 1 2 X

Surface pipe planned to be set ... 320'

Conductor pipe required

Projected Total Depth ... 4700' feet

Formation ... Mississippian

Well Drilled For: Well Class: Type Equipment: Oil SWD Infield Mud Rotary Gas Inj Pool Ext Air Rotary OWWO Expl Wildcat Cable

If OWWO: old well info as follows:

Operator

Well Name

Comp Date Old Total Depth

I certify that well will comply with K.S.A. 55-101, et seq., plus eventually plugging hole to KCC specifications. Western Kansas Date 2/4/87 Signature of Operator or Agent Robert B. Jenkins Title District Geologist

For KCC Use:

Conductor Pipe Required ... feet; Minimum Surface Pipe Required ... 275 feet per Alt.

This Authorization Expires 8-4-87 Approved By 2-4-87


Handwritten signatures and initials, including a circled '2'.

Must be filed with the K.C.C. five (5) days prior to commencing well  
This card void if drilling not started within six (6) months of date received by K.C.C.

### Important procedures to follow:

1. Notify District office before setting surface casing.
2. Set surface casing by circulating cement to the top.
3. File completion forms ACO-1 with K.C.C. within 90 days of well completion, following instructions on ACO-1, side 1, and including copies of wireline logs.
4. Notify District office 48 hours prior to old well workover or re-entry.
5. Prior to filing Intent, prepare a proposed plugging plan in case well is D & A, then obtain approval of plan when calling district office prior to setting surface pipe.
6. Submit plugging report (CP-4) to K.C.C. after plugging is completed.
7. Obtain an approved injection docket number before disposing of salt water.
8. Notify K.C.C. within 10 days when injection commences or terminates.

### A Regular Section of Land 1 Mile = 5,280 Ft.

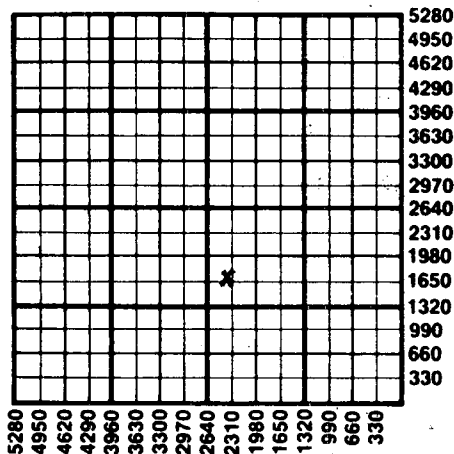

RECEIVED  
STATE CORPORATION COMMISSION

FEB 4 1987  
02-04-1987  
CONSERVATION DIVISION  
Wichita, Kansas

If an alternate 2 completion, cement in the production pipe from below any usable water to surface within 120 days of spud date.

State Corporation Commission of Kansas  
Conservation Division  
200 Colorado Derby Building  
Wichita, Kansas 67202  
(316) 263-3238

NOTICE OF INTENTION TO DRILL

(see rules on reverse side)

Starting Date ... February ... 10 ... 1987 ... month day year

API Number 15- 193-20,430-00-00

OPERATOR: License # 5181 Name SLAWSON, DONALD C. Address 200 Douglas Building City/State/Zip Wichita, Kansas 67202 Contact Person Bill Horigan Phone (316) 263-3201

SW NW SE Sec. 23 Twp. 9 S, Rg. 33 1640' Ft. from South Line of Section 2390' Ft. from East Line of Section

(Note: Locate well on Section Plat on reverse side)

CONTRACTOR: License # 5657 Name Slawson Drilling Co. City/State Wichita, Kansas

Nearest lease or unit boundary line 330' feet County Thomas

Well Drilled For: Well Class: Type Equipment: Oil SWD Infield Mud Rotary Gas Inj Pool Ext Air Rotary OWWO Expl Wildcat Cable

Lease Name Hansen U Well # 1 Ground surface elevation 3115' GR. (Seis) feet MSL Domestic well within 330 feet: yes no Municipal well within one mile: yes no Depth to bottom of fresh water 100' 250' Depth to bottom of usable water 1750'

If OWWO: old well info as follows:

Surface pipe by Alternate: 1 2 X Surface pipe planned to be set 320' Conductor pipe required Projected Total Depth 4700' Formation Mississippian

Operator Well Name Comp Date Old Total Depth

I certify that well will comply with K.S.A. 55-101, et seq., plus eventually plugging hole to KCC specifications. Western Kansas Date 2/4/87 Signature of Operator or Agent Robert B. Jenkins Title District Geologist

For KCC Use:

Conductor Pipe Required feet; Minimum Surface Pipe Required 275 feet per Alt. This Authorization Expires 8-1-87 Approved By 2-4-87

320' SP - Spud 2-(14-15)-87

Water well (to farmer)

Bob Raul

3115 1600 1515 300 1800

320' - 215' ex

SW NW SE Sec. 23 Twp. 9 S, Rg. 33 East West

PLUGGING PROPOSAL IF ABOVE IS D & A

This plugging proposal will be reviewed and approved or revised at the time the district office is called prior to setting surface casing (call 7 a.m. to 5 p.m. workdays).

1st plug @ 1750' 1800 feet depth with 100 w/ 2 shells sxs of 60/40 Poz. w/6% Gel 2nd plug @ 340' 340 feet depth with 40 sxs of 60/40 Poz. w/6% Gel 3rd plug @ 40' 10 feet depth with sxs of 60/40 Poz. w/6% Gel 4th plug @ feet depth with sxs of 5th plug @ feet depth with sxs of (2) Rathole with 10 15 sxs 190' 60% 6 7/8" (b) Mousehole with sxs

Exp. - 9:00 P.M.

NOTE: Agreement between operator and district office on plug placement and the amount of cement to be used is necessary prior to plugging.

In Addition: Call district office after well is either plugged or production casing is cemented in.

(Call 7 a.m. to 5 p.m. workdays)

District office use only:

API #15- 193-20430

Surface casing of feet set with sxs at hours 19

Alternate 1 or 2 surface pipe was used.

Alternate 2 cementing was completed @ ft. depth with 19

Hole plugged 19, agent

RECEIVED STATE CONSERVATION COMMISSION

REB 5 300 CONSERVATION DIVISION Wichita, Kansas