

CARD MUST BE TYPED

State of Kansas
NOTICE OF INTENTION TO DRILL
(see rules on reverse side)

CARD MUST BE SIGNED

Starting Date: May 6 1985
month day year

API Number 15- **193-20,352-00-00**

OPERATOR: License # **5205**

..... C. . NE . . NW $\frac{1}{4}$ Sec . 25 Twp . 9 . . S, Rge . 33. East
(location) West

Name **Mid-Continent Energy Corp.**

Address **120 S. Market, Suite 310**

City/State/Zip **Wichita, KS 67202**

Contact Person **Bradley R. Buehler**

Phone **316-265-9501**

..... **4620** Ft North from Southeast Corner of Section

..... **3300** Ft West from Southeast Corner of Section

(Note: Locate well on Section Plat on reverse side)

CONTRACTOR: License # **5418**

Nearest lease or unit boundary line **660** feet.

County **THOMAS**

Name **Allen Drilling Company**

Lease Name **THORPE** Well# **1**

City/State **Great Bend, KS 67530**

Domestic well within 330 feet : yes no

Municipal well within one mile : yes no

Well Drilled For: Well Class: Type Equipment:

- Oil Swd Infield Mud Rotary
- Gas Inj Pool Ext. Air Rotary
- OWWO Expl Wildcat Cable

Depth to Bottom of fresh water **200** ^{mfc} feet

Lowest usable water formation **Dakota**

Depth to Bottom of usable water **1800** feet

If OWWO: old well info as follows:

Surface pipe by Alternate : 1 2

Operator

Surface pipe to be set **300** feet

Well Name

Conductor pipe if any required feet

Comp Date Old Total Depth

Ground surface elevation feet MSL

Projected Total Depth **4750** feet

This Authorization Expires **11-2-85**

Projected Formation at TD **Mississippi**

Approved By **5-2-85** *[Signature]*

Expected Producing Formations **Lansing & Mississippi**

I certify that we will comply with K.S.A. 55-101, et seq., plus eventually plugging hole to K.C.C. specifications.

Date **5-1-85** Signature of Operator or Agent

Josh H. Buehler


Title **Land Manager**

MHC/UDHE 5-2-85

Must be filed with the K.C.C. five (5) days prior to commencing well
This card void if drilling not started within six (6) months of date received by K.C.C.

Important procedures to follow :

A Regular Section of Land
1 Mile = 5,280 Ft.

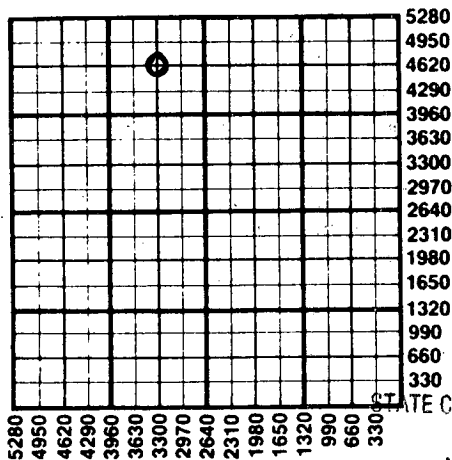

1. Notify District office before setting surface casing.
2. Set surface casing by circulating cement to the top.
3. File completion forms ACO-1 with K.C.C. within 90 days of well completion, following instructions on ACO-1, side 1, and including copies of wireline logs.
4. Notify District office 48 hours prior to old well workover or re-entry.
5. Prior to plugging, prepare a plugging plan, then obtain agreement from the appropriate district office for an approved plugging plan.
6. Submit plugging report (CP-4) to K.C.C. after plugging is completed.
7. Obtain an approved injection docket number before disposing of salt water.
8. Notify K.C.C. within 10 days when injection commences or terminates.
9. If an alternate 2 completion, cement in the production pipe from below any usable water to surface within 120 days of spud date.

RECEIVED
STATE CORPORATION COMMISSION

MAY 02 1985
05-02-1985
CONSERVATION DIVISION
Wichita, Kansas

State Corporation Commission of Kansas
Conservation Division
200 Colorado Derby Building
Wichita, Kansas 67202
(316) 263-3238