

CARD MUST BE TYPED

State of Kansas
NOTICE OF INTENTION TO DRILL
(see rules on reverse side)

CARD MUST BE SIGNED

Starting Date: 10-14-84
month day year

API Number is- 193-20,327-00-00

OPERATOR: License # 8301

NE SW SE East
(location) Sec 24 Twp 9 S, Rge 33 West

Name Staepfelwerth Drilg., Inc.

Address Box 978

City/State/Zip McCook, Nb. 69001

Contact Person Jack Lowry

Phone 308-345-1766

990 Ft North from Southeast Corner of Section
1650 Ft West from Southeast Corner of Section
(Note: Locate well on Section Plat on reverse side)

CONTRACTOR: License # Same

Nearest lease or unit boundary line 990= feet.

Name Same

County Thomas

City/State

Lease Name Lunsway Well# 1

Well Drilled For:

Well Class:

Type Equipment:

Oil Swd

Infield

Mud Rotary

Gas Inj

Pool Ext.

Air Rotary

OWWO Expl

Wildcat

Cable

If OWWO: old well info as follows:

Domestic well within 330 feet: yes no

Municipal well within one mile: yes no

Operator

Well Name

Comp Date

Old Total Depth

Projected Total Depth 4300 feet

Depth to Bottom of fresh water 190 feet

Lowest usable water formation 220 Dakota feet

Depth to Bottom of usable water 250 1800 feet

Surface pipe by Alternate: 1 2

Surface pipe to be set 300 feet

Conductor pipe if any required

Ground surface elevation 3135 feet MSL

This Authorization Expires 4-12-85

Approved By 10-12-84 *[Signature]*

I certify that we will comply with K.S.A. 55-101, et seq., plus eventually plugging hole to K.C.C. specifications.

Date 10-12-84 Signature of Operator or Agent *[Signature]*

Title as agent

WICHITA, KANSAS

NOTICE

10-21-1984

OCT 21 1984


Must be filed with the K.C.C. five (5) days prior to commencing well
This card void if drilling not started within six (6) months of date received by K.C.C.

STATE CORPORATION COMMISSION

RECEIVED

A Regular Section of Land

1 Mile = 5,280 Ft.

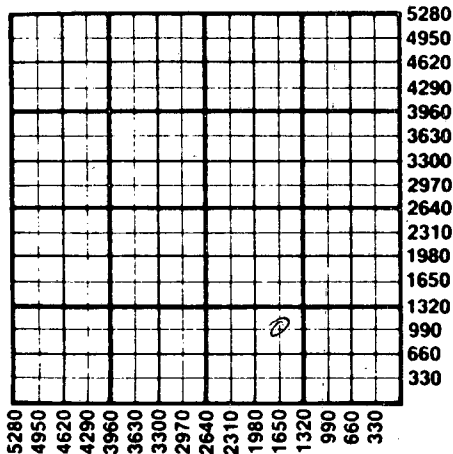

Important procedures to follow :

1. Notify District office before setting surface casing.
2. Set surface casing by circulating cement to the top.
3. File completion forms ACO-1 with K.C.C. within 90 days of well completion, following instructions on ACO-1, side 1, and including copies of wireline logs.
4. Notify District office 48 hours prior to old well workover or re-entry.
5. Prior to plugging, prepare a plugging plan, then obtain agreement from the appropriate district office for an approved plugging plan.
6. Submit plugging report (CP-4) to K.C.C. after plugging is completed.
7. Obtain an approved injection docket number before disposing of salt water.
8. Notify K.C.C. within 10 days when injection commences or terminates.
9. If an alternate 2 completion, cement in the production pipe from below any usable water to surface within 120 days of spud date.

State Corporation Commission of Kansas
 Conservation Division
 200 Colorado Derby Building
 Wichita, Kansas 67202
 (316) 263-3238