

CARD MUST BE TYPED

State of Kansas
NOTICE OF INTENTION TO DRILL
(see rules on reverse side)

CARD MUST BE SIGNED

Starting Date: 11 24 84
month day year 2:31

API Number 15- 179-20,782-00-00

OPERATOR: License # 5140

. SW . SW . SE Sec .3 . Twp 9 . S, Rge 29W
(location) East West

Name Frontier Oil Company

Address 1720 Kansas State Bank Bldg.

City/State/Zip Wichita, Kansas 67202

Contact Person George A. Angle

Phone 316-263-1201

330 Ft North from Southeast Corner of Section

2310 Ft West from Southeast Corner of Section

(Note: Locate well on Section Plat on reverse side)

CONTRACTOR: License # 5302

Nearest lease or unit boundary line 330 feet.

County Sheridan

Name Red Tiger Drilling Company

Lease Name Reitcheck Well# 1

City/State Wichita, Kansas 67202

Domestic well within 330 feet: yes no

Well Drilled For: Well Class: Type Equipment:

Municipal well within one mile: yes no

- Oil Swd Infield Mud Rotary
- Gas Inj Pool Ext. Air Rotary
- OWWO Expl Wildcat Cable

Depth to Bottom of fresh water 100-175 mke feet

Lowest usable water formation Dakota

Depth to Bottom of usable water 1500 feet

Surface pipe by Alternate: 1 2

Surface pipe to be set 200-225 feet

Conductor pipe if any required N/A feet

Ground surface elevation 2780 Gr. (L&S) feet MSL

This Authorization Expires 5-20-85

Approved By 11-20-84 [Signature]

If OWWO: old well info as follows:

Operator

Well Name

Comp Date Old Total Depth

Projected Total Depth 4200 feet

Projected Formation at TD Base Kansas City

Expected Producing Formations Base Kansas City

I certify that we will comply with K.S.A. 55-101, et seq., plus eventually plugging hole to K.C.C. specifications

Date 11/20/84

Signature of Operator or Agent

George A. Angle

Title

OWNER

mhc/kdhe 11/20/84

Must be filed with the K.C.C. five (5) days prior to commencing well
This card void if drilling not started within six (6) months of date received by K.C.C.


RECEIVED
STATE CORPORATION COMMISSION

NOV 20 1984

11-20-1984

UNIVERSITY OF KANSAS
A Regular Section of Land

1 Mile = 5,280 Ft.

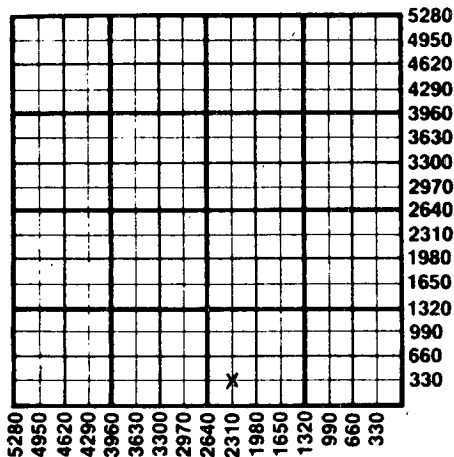

Important procedures to follow :

1. Notify District office before setting surface casing.
2. Set surface casing by circulating cement to the top.
3. File completion forms ACO-1 with K.C.C. within 90 days of well completion, following instructions on ACO-1, side 1, and including copies of wireline logs.
4. Notify District office 48 hours prior to old well workover or re-entry.
5. Prior to plugging, prepare a plugging plan, then obtain agreement from the appropriate district office for an approved plugging plan.
6. Submit plugging report (CP-4) to K.C.C. after plugging is completed.
7. Obtain an approved injection docket number before disposing of salt water.
8. Notify K.C.C. within 10 days when injection commences or terminates.
9. If an alternate 2 completion, cement in the production pipe from below any usable water to surface within 120 days of spud date.

State Corporation Commission of Kansas
Conservation Division
200 Colorado Derby Building
Wichita, Kansas 67202
(316) 263-3238