

FOR KCC USE:

FORM C-1 7/91

FORM MUST BE TYPED

EFFECTIVE DATE: 9-21-91

State of Kansas

FORM MUST BE SIGNED

DISTRICT # 4

NOTICE OF INTENTION TO DRILL

ALL BLANKS MUST BE FILLED

SGA7... Yes. X No

Must be approved by the K.C.C. five (5) days prior to commencing well

Spot SW SW Sec 21 Twp 9 S Rg 32 East West

Expected Spud Date 10 month 1 day 91 year

660 feet from South / North Line of Section 660 West line of Section IS SECTION X REGULAR IRREGULAR?

OPERATOR: License # 9121 Name: Kiwanda Energy, Inc. Address: Suite 608, 8101 E. Prentice Ave, City/State/Zip: Englewood, CO 80111 Contact Person: Earl Ochampaugh Phone: 303-721-7047

(NOTE: Locate well on the Section Plat on Reverse Side) County: Thomas

Lease Name: Renner Well #: 1 Field Name: Ohl. West

CONTRACTOR: License #: 30606 Name: Murfin Drilling Company, Inc.

Is this a Prorated/Spaced Field? yes X no Target Formation(s): Lansing-Kansas City

Well Drilled For: Well Class: Type Equipment: X Oil Enh Rec Infield X Mud Rotary Gas Storage X Pool Ext Air Rotary OWWO Disposal Wildcat Cable Seismic # of Holes Other

Nearest lease or unit boundary: 660 Ground Surface Elevation: 3092 feet MSL

If OWWO: old well information as follows: Operator: Well Name: Comp. Date: Old Total Depth:

Water well within one-quarter mile: X yes no Public water supply well within one mile: yes X no

Depth to bottom of fresh water: 200 Depth to bottom of usable water: 1890

Directional, Deviated or Horizontal wellbore? yes X no If yes, true vertical depth: Bottom Hole Location:

Surface Pipe by Alternate: 1 X 2 Length of Surface Pipe Planned to be set: 290

Length of Conductor pipe required: None Projected Total Depth: 4,800

Formation at Total Depth: Mississippian Water Source for Drilling Operations: X well farm pond other

DWR Permit #: Will Cores Be Taken?: yes X no

If yes, proposed zone:

AFFIDAVIT

The undersigned hereby affirms that the drilling, completion and eventual plugging of this well will comply with K.S.A. 55-101, et. seq.

It is agreed that the following minimum requirements will be met:

- 1. Notify the appropriate district office prior to spudding of well; 2. A copy of the approved notice of intent to drill shall be posted on each drilling rig; 3. The minimum amount of surface pipe as specified below shall be set by circulating cement to the top; in all cases surface pipe shall be set through all unconsolidated materials plus a minimum of 20 feet into the underlying formation; 4. If the well is dry hole, an agreement between the operator and the district office on plug length and placement is necessary prior to plugging; 5. The appropriate district office will be notified before well is either plugged or production casing is cemented in; 6. IF AN ALTERNATE II COMPLETION, PRODUCTION PIPE SHALL BE CEMENTED FROM BELOW ANY USABLE WATER TO SURFACE WITHIN 120 DAYS OF SPUD DATE. IN ALL CASES, NOTIFY DISTRICT OFFICE PRIOR TO ANY CEMENTING.

I hereby certify that the statements made herein are true and to the best of my knowledge and belief.

Date: 9/10/91 Signature of Operator or Agent: Clay P. Nedrick Jr. Title: Vice President

FOR KCC USE: API # 15- 193-20,572-00-00 Conductor pipe required None feet Minimum surface pipe required 150 feet per Alt. 2 Approved by: Mew 9-16-91 This authorization expires: 3-16-92 (This authorization void if drilling not started within 6 months of effective date.) Spud date: Agent:

RECEIVED STATE CORPORATION COMMISSION SEP 16 1991 09-16-1991 CONSERVATION DIVISION Wichita, Kansas

REMEMBER TO:

- File Drill Pit Application (form CDP-1) with Intent to Drill; - File Completion Form ACO-1 within 120 days of spud date; - File acreage attribution plat according to field proration orders; - Notify appropriate district office 48 hours prior to workover or re-entry; - Submit plugging report (CP-4) after plugging is completed; - Obtain written approval before disposing or injecting salt water.

Mail to: Conservation Division, 200 Colorado Derby Building, 202 W. First St., Wichita, Kansas 67202-1286.

Handwritten notes on the right margin: 21, 9, 32 W

IN ALL CASES PLOT THE INTENDED WELL ON THE PLAT BELOW

PLAT OF ACREAGE ATTRIBUTABLE TO A WELL IN A PRORATED OR SPACED FIELD

If the intended well is in a prorated or spaced field, please fully complete this side of the form. If the intended well is in a prorated or spaced field complete the plat below showing that the well will be properly located in relationship to other wells producing from the common source of supply. Please show all the wells within 1 mile of the boundaries of the proposed acreage attribution unit for gas wells and within 1/2 mile of the boundaries of the proposed acreage attribution unit for oil wells.



API NO. 15- _____
 OPERATOR Kiwanda Energy, Inc. LOCATION OF WELL: COUNTY Thomas
 LEASE Renner 660 feet from south/north line of section
 WELL NUMBER 1 660 feet from east/west line of section
 FIELD Ohl West SECTION 21 TWP 9 South RG 32 West

NUMBER OF ACRES ATTRIBUTABLE TO WELL 20 IS SECTION x REGULAR or _____ IRREGULAR
 QTR/QTR/QTR OF ACREAGE _____ - SW - SW **IF SECTION IS IRREGULAR, LOCATE WELL FROM NEAREST CORNER BOUNDARY.**

Section corner used: _____ NE _____ NW _____ SE x SW

PLAT

(Show location of the well and shade attributable acreage for prorated or spaced wells.)
 (Show footage to the nearest lease or unit boundary line.)

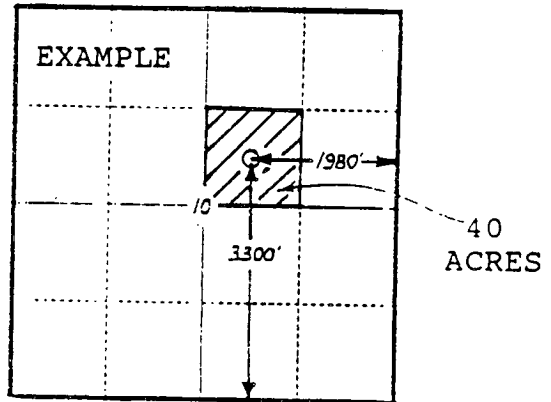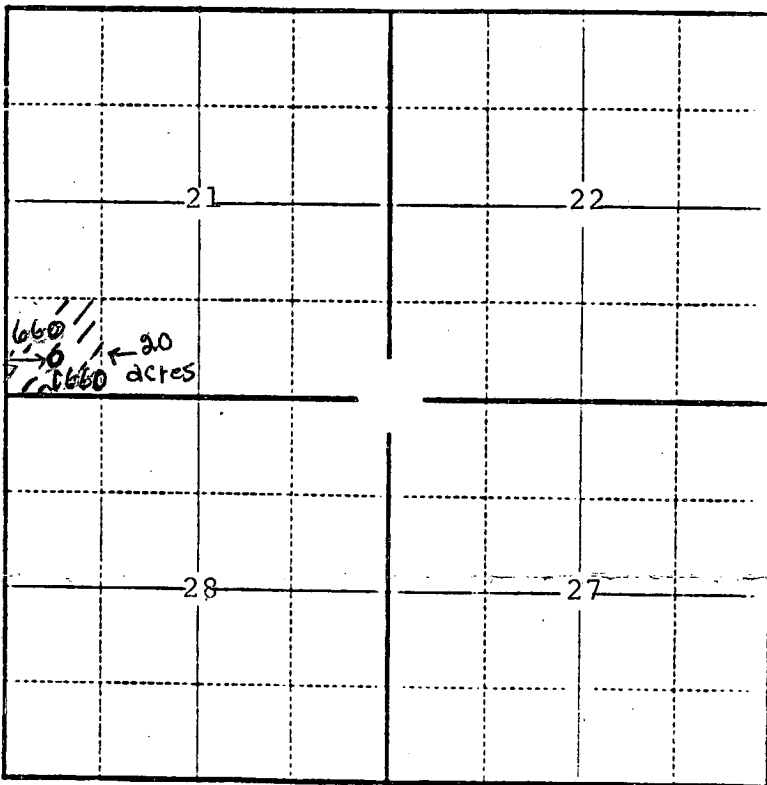

SEWARD CO.

In plotting the proposed location of the well, you must show:

- 1) The manner in which you are using the depicted plat by identifying section lines, i.e. 1 section, 1 section with 8 surrounding sections, 4 sections, etc.;
- 2) the distance of the proposed drilling location from the section's south/north and east/west lines; and
- 3) the distance to the nearest lease or unit boundary line.