

EFFECTIVE DATE: 2-5-97
DISTRICT # 4
SGA? Yes No

State of Kansas CORRECTION

FORM MUST BE TYPED
FORM MUST BE SIGNED
ALL BLANKS MUST BE FILLED

NOTICE OF INTENTION TO DRILL

Must be approved by the K.C.C. five (5) days prior to commencing well.

Expected Spud Date ..2.....13.....97.....
month day year

Spot X 50' NE of _____ East
SW--NE--NW.. Sec .22.. Twp ..9.. S, Rg ..32.. X West

OPERATOR: License #5135.....
Name:JOHN O. FARMER, INC.....
Address:P.O. BOX 352.....
City/State/Zip:RUSSELL, KS 67665.....
Contact Person:John O. Farmer IV.....
Phone:(913) 483-3144.....

X 955 ~~990~~ feet from South / (North) line of Section
X 1685 ~~1650~~ feet from East / (West) line of Section
IS SECTION X REGULAR _____ IRREGULAR?
(NOTE: Locate well on the Section Plat on Reverse Side)

CONTRACTOR: License #:30684.....
Name:Abercrombie RTD, Inc.....

County:Thomas.....
Lease Name: ...RENNER..... Well #:3.....
Field Name: ...OHL.NW.....
Is this a Prorated/Spaced Field? yes ..X.. no _____

Well Drilled For: Well Class: Type Equipment:
X. Oil ... Enh Rec ... Infield X. Mud Rotary
... Gas ... Storage X. Pool Ext. ... Air Rotary
... OWO ... Disposal ... Wildcat ... Cable
... Seismic; ... # of Holes ... Other
... Other

Target Formation(s):Lansing-Kansas City.....
Nearest lease or unit boundary:990'.....
Ground Surface Elevation:(est.)3070..... feet MSL
Water well within one-quarter mile: X. yes X.. no _____
Public water supply well within one mile: yes X.. no _____
Depth to bottom of fresh water:220'.....
Depth to bottom of usable water: ...1880'...(base.Dakota)..
Surface Pipe by Alternate: 1 ..X.. 2 ✓
Length of Surface Pipe Planned to be set:270'.....
Length of Conductor pipe required:NA.....
Projected Total Depth:4700'.....
Formation at Total Depth:Mississippi.....
Water Source for Drilling Operations:

If OWO: old well information as follows:
Operator:
Well Name:
Comp. Date: Old Total Depth

X. well farm pond other
(APPLY FOR FROM DWR)
Will Cores Be Taken?: yes ..X.. no _____
If yes, proposed zone:

Directional, Deviated or Horizontal wellbore? yes ..X.. no _____
If yes, true vertical depth:.....
Bottom Hole Location.....

X SPOT WAS: SW NE NW

AFFIDAVIT

The undersigned hereby affirms that the drilling, completion and eventual plugging of this well will comply with K.S.A. 55-101, et. seq.

It is agreed that the following minimum requirements will be met:

SPOT IS: 50' NE OF SW NE NW
WAS: 990' FNL 1650' FWL
IS: 955' FNL 1685' FWL

- 1. Notify the appropriate district office prior to spudding of well;
- 2. A copy of the approved notice of intent to drill shall be posted on each drilling rig;
- 3. The minimum amount of surface pipe as specified below shall be set by circulating cement to the top; in all cases surface pipe shall be set through all unconsolidated materials plus a minimum of 20 feet into the underlying formation;
- 4. If the well is dry hole, an agreement between the operator and the district office on plug length and placement is necessary prior to plugging;
- 5. The appropriate district office will be notified before well is either plugged or production casing is cemented in;
- 6. IF AN ALTERNATE II COMPLETION, PRODUCTION PIPE SHALL BE CEMENTED FROM BELOW ANY USABLE WATER TO SURFACE WITHIN 120 DAYS OF SPUD DATE. IN ALL CASES, NOTIFY DISTRICT OFFICE PRIOR TO ANY CEMENTING.

I hereby certify that the statements made herein are true and to the best of my knowledge and belief.

Date:1-29-97..... Signature of Operator or Agent: John O. Farmer Title:

FOR KCC USE:
API # 15- 193-206570000
Conductor pipe required NONE feet
Minimum surface pipe required 270 feet per Alt. X2
Approved by: JK 1-31-97 / COR 3-26-97 JK
This authorization expires: 7-31-97
(This authorization void if drilling not started within 6 months of effective date.)
Spud date: _____ Agent: _____

RECEIVED
KANSAS CORP COMM
1997 MAR 26 12:13
03-26-1997

REMEMBER TO:

- File Drill Pit Application (form CDP-1) with Intent to Drill;
- File Completion Form ACO-1 within 120 days of spud date;
- File acreage attribution plat according to field prorotation orders;
- Notify appropriate district office 48 hours prior to workover or re-entry;
- Submit plugging report (CP-4) after plugging is completed;
- Obtain written approval before disposing or injecting salt water.

Mail to: Conservation Division, 200 Colorado Derby Building, 202 W. First St., Wichita, Kansas 67202-1286.

27
9
320

EFFECTIVE DATE: 2-5-97

State of Kansas

DISTRICT # 4

NOTICE OF INTENTION TO DRILL

SGA? Yes No

Must be approved by the K.C.C. five (5) days prior to commencing well.

Expected Spud Date ..2.....13.....97.....
month day year

Spot 50' NE ΔF East
SW...NE...NW... Sec .22.. Twp ..9.. S, Rg ..32.. X West

OPERATOR: License #5135.....
Name:JOHN O. FARMER, INC.....
Address:P.O. BOX 352.....
City/State/Zip:RUSSELL, KS...67665.....
Contact Person:John O. Farmer IV.....
Phone:(913) 483-3144.....

955
990..... feet from South / North line of Section
4650' 1685' feet from East / West line of Section
IS SECTION X REGULAR _____ IRREGULAR?
(NOTE: Locate well on the Section Plat on Reverse Side)

CONTRACTOR: License #:30684.....
Name:Abercrombie RTD, Inc.....

County:Thomas.....

Lease Name: ...RENNER..... Well #:3.....

Field Name: ...OHL.NW.....

Is this a Prorated/Spaced Field? yes ..X.. no

Target Formation(s):Lansing-Kansas City.....

Nearest lease or unit boundary:990'.....

Ground Surface Elevation:(est.)3070..... feet MSL

Water well within one-quarter mile: X. yes X. no

Public water supply well within one mile: yes .X.. no

Depth to bottom of fresh water:220'.....

Depth to bottom of usable water: ...1880'...(base.Dakota).....

Surface Pipe by Alternate: 1 ..X. 2

Length of Surface Pipe Planned to be set:270'.....

Length of Conductor pipe required:NA.....

Projected Total Depth:4700'.....

Formation at Total Depth:Mississippi.....

Water Source for Drilling Operations:

X. well farm pond other

(APPLY FOR FROM DWR)

Will Cores Be Taken?: yes ..X.. no

If yes, proposed zone:

Well Drilled For: Well Class: Type Equipment:

- Oil Enh Rec Infield Mud Rotary
- Gas Storage Pool Ext. Air Rotary
- OWWO Disposal Wildcat Cable
- Seismic; # of Holes Other
- Other

If OWWO: old well information as follows:

Operator:

Well Name:

Comp. Date: Old Total Depth

Directional, Deviated or Horizontal wellbore? yes .X.. no

If yes, true vertical depth:

Bottom Hole Location:

CORRECTION 3-26-97 JK

AFFIDAVIT

The undersigned hereby affirms that the drilling, completion and eventual plugging of this well will comply with K.S.A. 55-101, et. seq.

It is agreed that the following minimum requirements will be met:

1. Notify the appropriate district office prior to spudding of well;
2. A copy of the approved notice of intent to drill shall be posted on each drilling rig;
3. The minimum amount of surface pipe as specified below shall be set by circulating cement to the top; in all cases surface pipe shall be set through all unconsolidated materials plus a minimum of 20 feet into the underlying formation;
4. If the well is dry hole, an agreement between the operator and the district office on plug length and placement is necessary prior to plugging;
5. The appropriate district office will be notified before well is either plugged or production casing is cemented in;
6. IF AN ALTERNATE II COMPLETION, PRODUCTION PIPE SHALL BE CEMENTED FROM BELOW ANY USABLE WATER TO SURFACE WITHIN 120 DAYS OF SPUD DATE. IN ALL CASES, NOTIFY DISTRICT OFFICE PRIOR TO ANY CEMENTING.

I hereby certify that the statements made herein are true and to the best of my knowledge and belief.

Date:1-29-97..... Signature of Operator or Agent: John O. Farmer, Jr. Title:Geologist.....

FOR KCC USE:
 API # 15- 193-206570000
 Conductor pipe required NONE feet
 Minimum surface pipe required 270 feet per Alt. (X)(2)
 Approved by: JK 1-31-97
 This authorization expires: 7-31-97
 (This authorization void if drilling not started within 6 months of effective date.)
 Spud date: _____ Agent: _____

REMEMBER TO:

- File Drill Pit Application (form CDP-1) with Intent to Drill;
- File Completion Form ACO-1 within 120 days of spud date;
- File acreage attribution plat according to field proration orders;
- Notify appropriate district office 48 hours prior to workover or re-entry;
- Submit plugging report (CP-4) after plugging is completed;
- Obtain written approval before disposing or injecting salt water.

Mail to: Conservation Division, 200 Colorado Derby Building, 202 W. First St., Wichita, Kansas 67202-1286.

RECEIVED
KANSAS CORP COM
1997 JAN 31 P 12:31
JK 9 320

IN ALL CASES PLOT THE INTENDED WELL ON THE PLAT BELOW

PLAT OF ACREAGE ATTRIBUTABLE TO A WELL IN A PRORATED OR SPACED FIELD

If the intended well is in a prorated or spaced field, please fully complete this side of the form. If the intended well is in a prorated or spaced field complete the plat below showing that the well will be properly located in relationship to other wells producing from the common source of supply. Please show all the wells within 1 mile of the boundaries of the proposed acreage attribution unit for gas wells and within 1/2 mile of the boundaries of the proposed acreage attribution unit for oil wells.

API NO. 15- _____
 OPERATOR _____
 LEASE _____
 WELL NUMBER _____
 FIELD _____

LOCATION OF WELL: COUNTY _____
 _____ feet from south/north line of section
 _____ feet from east/west line of section
 SECTION _____ TWP _____ RG _____



NUMBER OF ACRES ATTRIBUTABLE TO WELL _____
 QTR/QTR/QTR OF ACREAGE _____ - _____ - _____

IS SECTION _____ REGULAR or _____ IRREGULAR
IF SECTION IS IRREGULAR, LOCATE WELL FROM NEAREST CORNER BOUNDARY.

Section corner used: _____ NE _____ NW _____ SE _____ SW

PLAT

(Show location of the well and shade attributable acreage for prorated or spaced wells.)
 (Show footage to the nearest lease or unit boundary line.)

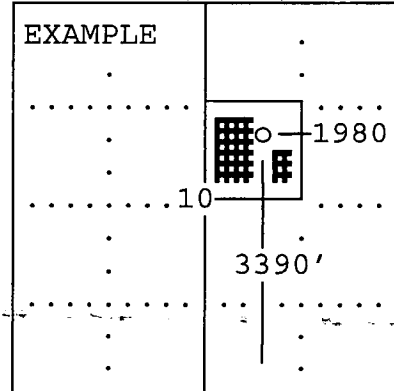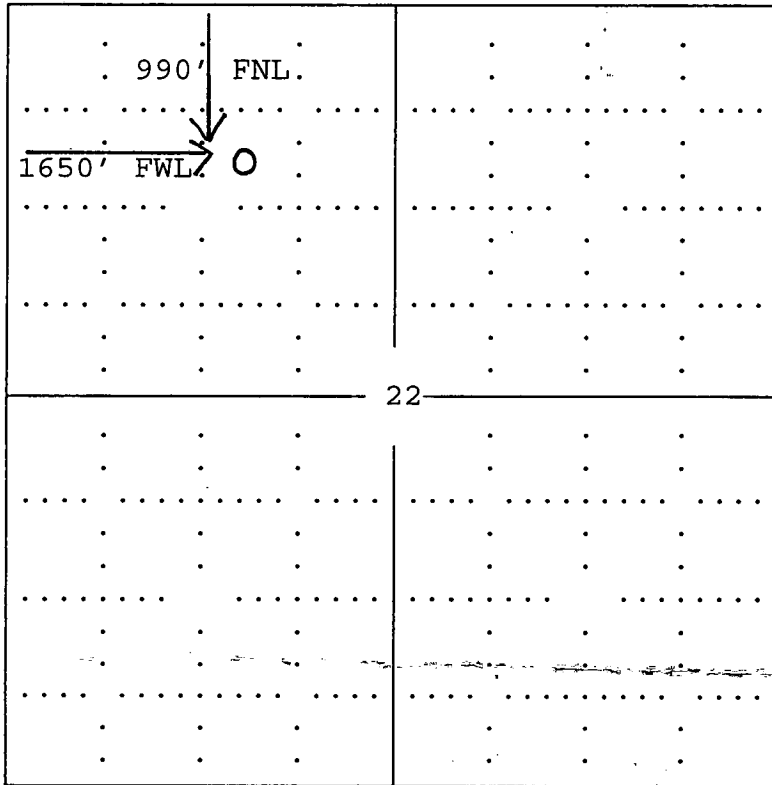

SEWARD CO.

In plotting the proposed location of the well, you must show:

- 1) The manner in which you are using the depicted plat by identifying section lines, i.e. 1 section, 1 section with 8 surrounding sections, 4 sections, etc.;
- 2) the distance of the proposed drilling location from the section's south/north and east/west; and
- 3) the distance to the nearest lease or unit boundary line.