

EFFECTIVE DATE: 1-19-91

FORM MUST BE TYPED  
FORM C-1 4/90

State of Kansas  
NOTICE OF INTENTION TO DRILL

FORM MUST BE SIGNED  
ALL BLANKS MUST BE FILLED

Must be approved by the K.C.C. five (5) days prior to commencing well

Expected Spud Date January 13, 1991  
month day year

SE SE SW Sec 36 Twp 9 S, Rg 32 XX East West ✓

OPERATOR: License # 6484 6484 ✓  
Name: Anderson Energy, Inc.  
Address: 200 E. First St., Suite 414  
City/State/Zip: Wichita, KS 67202  
Contact Person: William L. Anderson  
Phone: (316) 265-7929

330 feet from South line of Section ✓  
2970 feet from East line of Section ✓  
(Note: Locate well on Section Plat on Reverse Side)

CONTRACTOR: License #: 5420  
Name: White & Ellis Drilling, Inc.

County: Thomas  
Lease Name: Sims Well #: 1  
Field Name: Unknown

Well Drilled For: Well Class: Type Equipment:  
 Oil ... Inj ... Infield  Mud Rotary ✓  
... Gas ... Storage  Pool Ext. ... Air Rotary  
... OWD ... Disposal ... Wildcat ... Cable  
... Seismic; ... # of Holes

Is this a Prorated Field? ... yes  no  
Target Formation(s): Lansing-Marmaton  
Nearest lease or unit boundary: 330  
Ground Surface Elevation: 3064 feet MSL  
Domestic well within 330 feet: ... yes  no  
Municipal well within one mile: ... yes  no  
Depth to bottom of fresh water: 200  
Depth to bottom of usable water: 1915  
Surface Pipe by Alternate: ... 1  2  
Length of Surface Pipe Planned to be set: 250'  
Length of Conductor pipe required: N/A  
Projected Total Depth: 4750'  
Formation at Total Depth: Mississippi  
Water Source for Drilling Operations:  
... well ... farm pond  other ✓

If OWWO: old well information as follows:  
Operator: \_\_\_\_\_  
Well Name: \_\_\_\_\_  
Comp. Date: \_\_\_\_\_ Old Total Depth \_\_\_\_\_

Directional, Deviated or Horizontal wellbore? ... yes  no  
If yes, total depth location: \_\_\_\_\_

DWR Permit #: \_\_\_\_\_  
Will Cores Be Taken?: ... yes  no  
If yes, proposed zone: \_\_\_\_\_

AFFIDAVIT

The undersigned hereby affirms that the drilling, completion and eventual plugging of this well will comply with K.S.A. 55-101, et. seq.

- It is agreed that the following minimum requirements will be met:
1. The appropriate district office shall be notified before setting surface pipe;
  2. The minimum amount of surface pipe as specified above shall be set by circulating cement to the top; in all cases surface pipe shall be set through all unconsolidated materials plus a minimum of 20 feet into the underlying formation;
  3. If the well is dry, a plugging proposal shall be submitted to the district office. An agreement between the operator and the district office on plug length and placement is necessary prior to plugging;
  4. The appropriate district office will be notified before well is either plugged or production casing is cemented in;
  5. If an Alternate II completion, production pipe shall be cemented from below any usable water to surface within 120 days of spud date. In all cases, notify district office prior to any cementing.

I hereby certify that the statements made herein are true and to the best of my knowledge and belief.

Date: 1/7/91 Signature of Operator or Agent: William L. Anderson Title: Secy-Treas.

FOR KCC USE:  
API # 15- 193-20,542-00-00  
Conductor pipe required None feet  
Minimum surface pipe required 150 feet per Alt. (E)  
Approved by: mwj-14-91  
EFFECTIVE DATE: 1-19-91 7-14-91  
This authorization expires: \_\_\_\_\_  
(This authorization void if drilling not started within 6 months of effective date.)  
Spud date: \_\_\_\_\_ Agent: \_\_\_\_\_

RECEIVED  
STATE CORPORATION COMMISSION  
JAN 14 1991  
01-14-1991  
CONSERVATION DIVISION  
Wichita, Kansas  
RECEIVED  
STATE CORPORATION COMMISSION  
JAN 9 1991  
CONSERVATION DIVISION  
Wichita, Kansas  
36  
9  
3221

REMEMBER TO:

- File Drill Pit Application (form CDP-1) with Intent to Drill;
- File Completion Form ACO-1 within 120 days of spud date;
- File acreage attribution plat according to field proration orders;
- Notify appropriate district office 48 hours prior to workover or re-entry;
- Submit plugging report (CP-4) after plugging is completed;
- Obtain written approval before disposing or injecting salt water.


**PLAT OF ACREAGE ATTRIBUTABLE TO A WELL**

State Corporation Commission, Conservation Division  
200 Colorado Derby Bldg. Wichita, Kansas 67202

OPERATOR Anderson Energy, Inc.  
LEASE Sims  
WELL NUMBER 1  
FIELD Wildcat  
NO. OF ACRES ATTRIBUTABLE TO WELL 10  
DESCRIPTION OF ACREAGE SE SE SW

LOCATION OF WELL:  
330 feet north of SE corner  
2970 feet west of SE corner  
SW/4 Sec. 36 T 9 R 32 ~~SW~~  
COUNTY Thomas  
IS SECTION X REGULAR      IRREGULAR?  
IF IRREGULAR, LOCATE WELL FROM NEAREST  
CORNER BOUNDARY.

NOTE: If plat depicted is insufficient for your circumstances, you may attach your own scaled or surveyed plat.

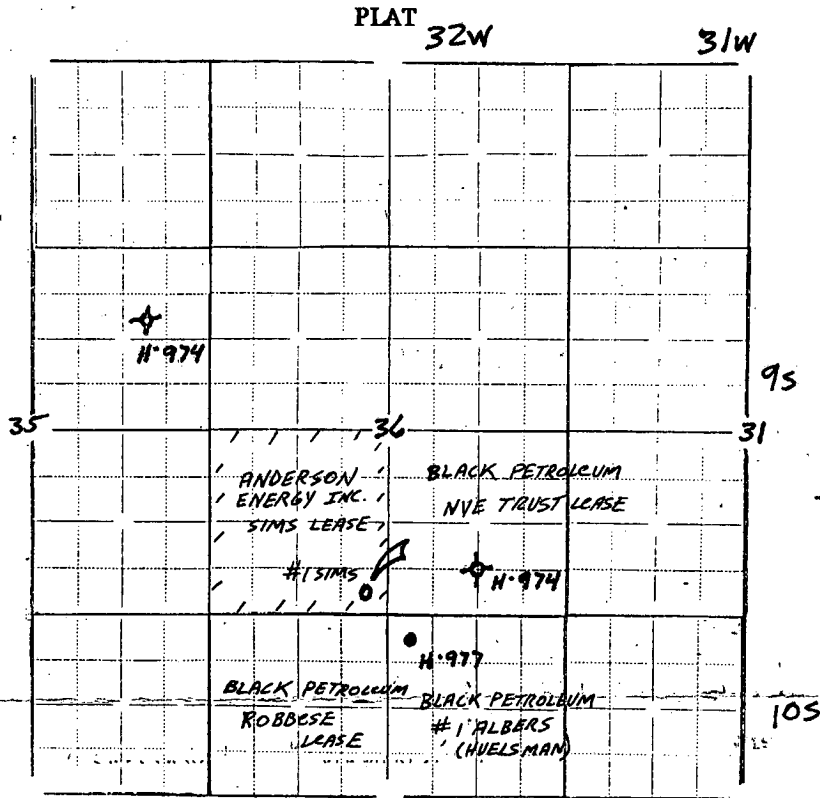

In plotting the proposed location of the well, you must show:

- 1) The manner in which you are using the depicted plat by identifying section lines, i.e. 1 section, 1 section with 8 surrounding partial sections, 4 sections, 16 sections, etc.;
- 2) the well's location relative to the location of other wells producing from the same common source of supply in adjoining drilling units, pursuant to K.A.R. 82-3-108, 82-3-207, 82-3-312, or special orders of the Commission;
- 3) the distance of the proposed drilling location from the section's east and south lines; and
- 4) the distance to the nearest lease or unit boundary line.

I hereby certify that the statements made herein are true and to the best of my knowledge and belief.

Signature of Operator or Agent William J. Anderson  
Date 1/7/91 Title Secy-Treas.