

NOTICE OF INTENTION TO DRILL

(see rules on reverse side)

Starting Date 12 month 14 day 85 year

API Number 15-193-20,385-00-00

OPERATOR: License # 5123 & 4277
Name Pickrell Drlg. Co. & Bruce Anderson
Address 110 N. Market, Suite 205
City/State/Zip Wichita, KS 67202
Contact Person Jay McNeil
Phone 262-8427

C NE SE Sec. 27 Twp. 9 S, Rg. 32 XX East West
1990 Ft. from South Line of Section
660 Ft. from East Line of Section

(Note: Locate well on Section Plat on reverse side)

CONTRACTOR: License # 5123
Name Pickrell Drilling Company
City/State Wichita, Kansas

Nearest lease or unit boundary line 660 feet
County Thomas
Lease Name Olson Well # 1

Well Drilled For: Well Class: Type Equipment:
X Oil SWD Infield X Mud Rotary
X Gas Inj Pool Ext. Air Rotary
OWWO Expl X Wildcat Cable

Ground surface elevation 3065 feet MSL
Domestic well within 330 feet: yes X no
Municipal well within one mile: yes X no
Surface pipe by Alternate: 1 2 X
Depth to bottom of fresh water 200
Depth to bottom of usable water 1800
Surface pipe planned to be set 300+
Projected Total Depth 4700 feet
Formation Mississippi

If OWWO: old well info as follows:

Operator
Well Name
Comp Date Old Total Depth

I certify that well will comply with K.S.A. 55-101, et seq., plus eventually plugging hole to KCC specifications.

cementing will be done immediately upon setting production casing.

Date 12-9-85 Signature of Operator or Agent Title Chief Geologist


For KCC Use:

Conductor Pipe Required feet; Minimum Surface Pipe Required feet per Alt. 2

This Authorization Expires 6-9-86 Approved By RCH 12-9-85

Must be filed with the K.C.C. five (5) days prior to commencing well
This card void if drilling not started within six (6) months of date received by K.C.C.

A Regular Section of Land
1 Mile = 5,280 Ft.

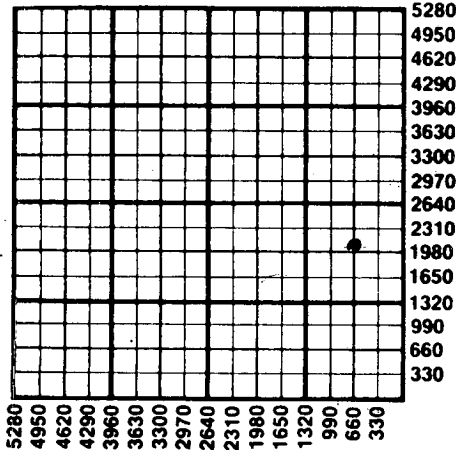

RECEIVED
STATE CORPORATION COMMISSION

DEC 09 1985
CONSERVATION DIVISION
Wichita, Kansas

12-09-1985

Important procedures to follow:

1. Notify District office before setting surface casing.
2. Set surface casing by circulating cement to the top.
3. File completion forms ACO-1 with K.C.C. within 90 days of well completion, following instructions on ACO-1, side 1, and including copies of wireline logs.
4. Notify District office 48 hours prior to old well workover or re-entry.
5. Prior to filing Intent, prepare a proposed plugging plan in case well is D & A, then obtain approval of plan when calling district office prior to setting surface pipe.
6. Submit plugging report (CP-4) to K.C.C. after plugging is completed.
7. Obtain an approved injection docket number before disposing of salt water.
8. Notify K.C.C. within 10 days when injection commences or terminates.
9. If an alternate 2 completion, cement in the production pipe from below any usable water to surface within 120 days of spud date.

State Corporation Commission of Kansas
Conservation Division
200 Colorado Derby Building
Wichita, Kansas 67202
(316) 263-3238