

CARD MUST BE TYPED

State of Kansas
NOTICE OF INTENTION TO DRILL
(see rules on reverse side)

CARD MUST BE SIGNED

Starting Date: 5-13-85
month day year

API Number 15- 179-20,811-00-00

OPERATOR: License # 5011

. S.W. SE. NE ... Sec . 8 . Twp . 9 . S, Rge . 26. East
(location) West

Name Viking Resources

Address 217 East William

City/State/Zip Wichita, KS 67202-4005

Contact Person Jim Devlin

Phone 316-262-2502

..... 2970 Ft North from Southeast Corner of Section

..... 990 Ft West from Southeast Corner of Section

(Note: Locate well on Section Plat on reverse side)

CONTRACTOR: License # 5420

Nearest lease or unit boundary line 330 feet.

County Sheridan

Name White and Ellis Drilling, Inc.

Lease Name Minium Well # 1

City/State Wichita, KS 67202-3484

Well Drilled For: Well Class: Type Equipment:

- Oil Swd Infield Mud Rotary
- Gas Inj Pool Ext. Air Rotary
- OWWO Expl Wildcat Cable

Domestic well within 330 feet : yes no

Municipal well within one mile : yes no

If OWWO: old well info as follows:

Operator

Well Name

Comp Date Old Total Depth

Projected Total Depth 4000 feet

Projected Formation at TD BKC

Expected Producing Formations LKC

Depth to Bottom of fresh water 150 200 mhc feet

Lowest usable water formation Dakota

Depth to Bottom of usable water 1400 feet

Surface pipe by Alternate : 1 2

Surface pipe to be set 200 250 mhc feet

Conductor pipe if any required None feet

Ground surface elevation Est: 2630 Unknown mhc feet MSL

This Authorization Expires 10-16-85

Approved By 9-16-85 *R*

I certify that we will comply with K.S.A. 55-101, et seq., plus eventually plugging hole to K.C.C. specifications.

Date 4 April 1985

James B. Decker
Signature of Operator or Agent

Partner

mhc/1401E 4-16-85

Must be filed with the K.C.C. five (5) days prior to commencing well
This card void if drilling not started within six (6) months of date received by K.C.C.


RECEIVED

STATE CORPORATION COMMISSION

APR 16 1985

04-16-1985

A Regular Section of Land
Conservation Division
1/4 Mile, 5,280 Ft.
Wichita, Kansas

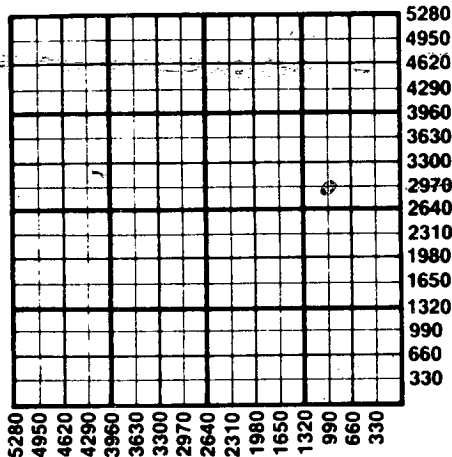

Important procedures to follow:

1. Notify District office before setting surface casing.
2. Set surface casing by circulating cement to the top.
3. File completion forms ACO-1 with K.C.C. within 90 days of well completion, following instructions on ACO-1, side 1, and including copies of wireline logs.
4. Notify District office 48 hours prior to old well workover or re-entry.
5. Prior to plugging, prepare a plugging plan, then obtain agreement from the appropriate district office for an approved plugging plan.
6. Submit plugging report (CP-4) to K.C.C. after plugging is completed.
7. Obtain an approved injection docket number before disposing of salt water.
8. Notify K.C.C. within 10 days when injection commences or terminates.
9. If an alternate 2 completion, cement in the production pipe from below any usable water to surface within 120 days of spud date.

State Corporation Commission of Kansas
Conservation Division
200 Colorado Derby Building
Wichita, Kansas 67202
(316) 263-3238