

NOTICE OF INTENTION TO DRILL

(see rules on reverse side)

Starting Date 1 18 87 month day year

API Number 15- 179-20,886-00-00

OPERATOR: License # 5146

NW SE SW 27 9 S, Rg 26 East West

Name Rains & Williamson Oil Co., Inc.

990 Ft. from South Line of Section

Address 435 Page Court, 220 West Douglas

3630 Ft. from East Line of Section

City/State/Zip Wichita, Kansas 67202

(Note: Locate well on Section Plat on reverse side)

Contact Person Juanita Green

Nearest lease or unit boundary line 990 feet

Phone (316) 265-9686

County Sheridan

CONTRACTOR: License # 5146

Lease Name L. & K. SIMON Well # 1

Name Same as Above

Ground surface elevation feet MSL

City/State

Domestic well within 330 feet: yes no

Well Drilled For: Well Class: Type Equipment:

Municipal well within one mile: yes no

X Oil SWD Infield X Mud Rotary

Depth to bottom of fresh water 100/150

X Gas Inj Pool Ext Air Rotary

Depth to bottom of usable water 1350

OWWO Expl Wildcat Cable

Surface pipe by Alternate: 1 2 X

If OWWO: old well info as follows:

Surface pipe planned to be set 300

Operator

Conductor pipe required -0-

Well Name

Projected Total Depth 4100 feet

Comp Date Old Total Depth

Formation Lansing

I certify that well will comply with K.S.A. 55-101, et seq., plus eventually plugging hole to KCC specifications.

Date 1-13-87 Signature of Operator or Agent

Title PRESIDENT

Signature of Operator or Agent

For KCC Use:

Conductor Pipe Required feet; Minimum Surface Pipe Required 200 feet per Alt. 40

This Authorization Expires 7-14-87 Approved By 1-14-87

Handwritten signature and initials


Must be filed with the K.C.C. five (5) days prior to commencing well
This card void if drilling not started within six (6) months of date received by K.C.C.

12

Important procedures to follow:

1. Notify District office before setting surface casing.
2. Set surface casing by circulating cement to the top.
3. File completion forms ACO-1 with K.C.C. within 90 days of well completion, following instructions on ACO-1, side 1, and including copies of wireline logs.
4. Notify District office 48 hours prior to old well workover or re-entry.
5. Prior to filing Intent, prepare a proposed plugging plan in case well is D & A, then obtain approval of plan when calling district office prior to setting surface pipe.
6. Submit plugging report (CP-4) to K.C.C. after plugging is completed.
7. Obtain an approved injection docket number before disposing of salt water.
8. Notify K.C.C. within 10 days when injection commences or terminates.
9. If an alternate 2 completion, cement in the production pipe from below any usable water to surface within 120 days of spud date.

A Regular Section of Land 1 Mile = 5,280 Ft.

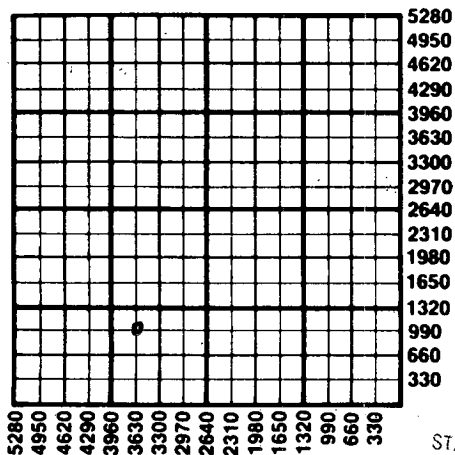

STATE CORPORATION COMMISSION

JAN 14 1987
01-14-1987
CONSERVATION DIVISION
Wichita, Kansas

State Corporation Commission of Kansas
Conservation Division
200 Colorado Derby Building
Wichita, Kansas 67202
(316) 263-3238

CARD MUST BE TYPED

State of Kansas

Plugged 2-1-87

CARD MUST BE SIGNED

NOTICE OF INTENTION TO DRILL

(see rules on reverse side)

Starting Date 1 18 87
month day year

API Number 15- *179-20,886* *Rec'd 1-14-87*

OPERATOR: License # 5146

NW SE SW Sec. 27 Twp. 9 S, Rg. 26 East

Name Rains & Williamson Oil Co., Inc.

990 Ft. from South Line of Section

Address 435 Page Court, 220 West Douglas

3630 Ft. from East Line of Section

City/State/Zip Wichita, Kansas 67202

(Note: Locate well on Section Plat on reverse side)

Contact Person Juanita Green

Nearest lease or unit boundary line 990 feet

Phone (316) 265-9686

County Sheridan

CONTRACTOR: License # 5146

Lease Name L. & K. SIMON Well # 1

Name Same as Above

Ground surface elevation feet MSL

City/State

Domestic well within 330 feet: yes no

Well Drilled For: Well Class: Type Equipment:

Municipal well within one mile: yes no

Oil SWD Infield Mud Rotary

Depth to bottom of fresh water 100 150

Gas Inj Pool Ext. Air Rotary

Depth to bottom of usable water 1350

OWWO Expl Wildcat Cable

Surface pipe by Alternate: 1 2

If OWWO: old well info as follows:

Surface pipe planned to be set 300

Operator

Conductor pipe required 0

Well Name

Projected Total Depth 4100 feet

Comp Date Old Total Depth

Formation Lansing

I certify that well will comply with K.S.A. 55-101, et seq., plus eventually plugging hole to KCC specifications.

Date 1-13-87 Signature of Operator or Agent *Wilson Rains* Title PRESIDENT

For KCC Use:

Conductor Pipe Required feet; Minimum Surface Pipe Required 200 feet per Alt. 4 2

This Authorization Expires 2-14-87 Approved By *1-14-87*

spud on 1/26/87

irrigation well

W. R. Goolbsy

John Rains

N/2 NW NW Sec. 3 Twp. 10 S, Rg. 26 East

PLUGGING PROPOSAL IF ABOVE IS D & A

This plugging proposal will be reviewed and approved or revised at the time the district office is called prior to setting surface casing (call 7 a.m. to 5 p.m. workdays).

1st plug @ 2215	feet depth with 20	sxs of 50-50 poz.
2nd plug @ 1300	feet depth with 100	sxs of 50-50 poz.
3rd plug @ 350	feet depth with 40	sxs of 50-50 poz.
4th plug @ 40	feet depth with 10	sxs of 50-50 poz.
5th plug @	feet depth with	sxs of
(2) Rathole with 10	sxs	(b) Mousehole with sxs

NOTE: Agreement between operator and district office on plug placement and the amount of cement to be used is necessary prior to plugging. In Addition: Call district office after well is either plugged or production casing is cemented in.

(Call 7 a.m. to 5 p.m. workdays)

District office use only:

API #15- *179-20,886*
Surface casing of feet set with sxs at hours, 19
Alternate 1 or 2 surface pipe was used.
Alternate 2 cementing was completed @ ft. depth with sxs on, 19
Hole plugged, 19, agent

STATE CORPORATION COMMISSION

Form C-1 12/85

REC 0 007

JAN 15 1987

STATE OF KANSAS