

CARD MUST BE TYPED



State of Kansas
NOTICE OF INTENTION TO DRILL
(see rules on reverse side)

CARD MUST BE SIGNED

Starting Date: June 17, 1985
month day year

API Number 15- 179-20,800-A00-01

OPERATOR: License # 5068
Name Thomas E. Black
Address 527 Union Center Bldg.
City/State/Zip Wichita, Kansas 67202
Contact Person Thomas E. Black
Phone 316-264-9342

SE SE SE (location) Sec 33 Twp 9 S, Rge 26 East West

330 Ft North from Southeast Corner of Section
330 Ft West from Southeast Corner of Section
(Note: Locate well on Section Plat on reverse side)

CONTRACTOR: License # 5110
Name B & B Drilling, Inc.
City/State Wichita, Kansas

Nearest lease or unit boundary line 330 feet.
County Sheridan

Lease Name JAMISON Well# #2

Domestic well within 330 feet: yes no
Municipal well within one mile: yes no

Well Drilled For:	Well Class:	Type Equipment:
<input checked="" type="checkbox"/> Oil <input type="checkbox"/> Swd <input type="checkbox"/> Infield <input checked="" type="checkbox"/> Mud Rotary	<input type="checkbox"/> Gas <input type="checkbox"/> Inj <input checked="" type="checkbox"/> Pool Ext. <input type="checkbox"/> Air Rotary	<input type="checkbox"/> Cable
<input checked="" type="checkbox"/> OWWO <input type="checkbox"/> Expl <input type="checkbox"/> Wildcat		

Depth to Bottom of fresh water feet
Lowest usable water formation feet
Depth to Bottom of usable water ^{Dalata} 1350 feet

Surface pipe by Alternate: 1 2
Surface pipe ~~set~~ set 308 feet
Conductor pipe if any required feet
Ground surface elevation' feet MSL

This Authorization Expires 12-14-85
Approved By 6-14-85 *R*

I certify that we will comply with K.S.A. 55-101, et seq., plus eventually plugging hole to K.C.C. specifications.

Date 6-14-85 Signature of Operator or Agent


Thomas E. Black Title

Owner
RCH FOR HOME

RECEIVED
STATE CORPORATION COMMISSION

Must be filed with the K.C.C. five (5) days prior to commencing well
and void if drilling not started within six (6) months of date received by K.C.C.

JUN 14 1985
06-14-1985
CONSERVATION DIVISION
A Regular Section of Land
1 Mile = 5,280 Ft.

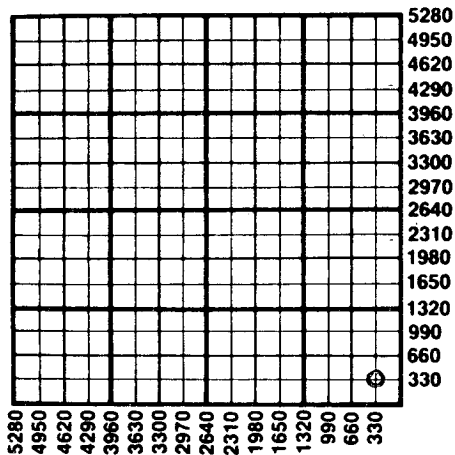

Important procedures to follow :

1. Notify District office before setting surface casing.
2. Set surface casing by circulating cement to the top.
3. File completion forms ACO-1 with K.C.C. within 90 days of well completion, following instructions on ACO-1, side I, and including copies of wireline logs.
4. Notify District office 48 hours prior to old well workover or re-entry.
5. Prior to plugging, prepare a plugging plan, then obtain agreement from the appropriate district office for an approved plugging plan.
6. Submit plugging report (CP-4) to K.C.C. after plugging is completed.
7. Obtain an approved injection docket number before disposing of salt water.
8. Notify K.C.C. within 10 days when injection commences or terminates.
9. If an alternate 2 completion, cement in the production pipe from below any usable water to surface within 120 days of spud date.

State Corporation Commission of Kansas
Conservation Division
200 Colorado Derby Building
Wichita, Kansas 67202
(316) 263-3238