

CARD MUST BE TYPED

State of Kansas

CARD MUST BE SIGNED

NOTICE OF INTENTION TO DRILL

(see rules on reverse side)

Starting Date 1 10 87 month day year

API Number 15-179-20,885-00-00

OPERATOR: License # 5146 Name Rains & Williamson Oil Co., Inc. Address 435 Page Court, 220 West Douglas City/State/Zip Wichita, Kansas 67202 Contact Person Juanita Green Phone (316) 265-9686

SW SE NW Sec. 36 Twp. 9 S, Rg. 26 West 2970 Ft. from South Line of Section 3630 Ft. from East Line of Section

(Note: Locate well on Section Plat on reverse side)

CONTRACTOR: License # 5146 Name Same as Above City/State

Nearest lease or unit boundary line 330 feet County Sheridan Lease Name FORE Well # 1

Well Drilled For: Well Class: Type Equipment: Oil SWD Infield Mud Rotary Gas Inj Pool Ext Air Rotary OWWO Expl Wildcat Cable

Ground surface elevation feet MSL Domestic well within 330 feet: yes no Municipal well within one mile: yes no Depth to bottom of fresh water 100-180 Depth to bottom of usable water 1350 Surface pipe by Alternate: 1 2 X Surface pipe planned to be set 300 Conductor pipe required -0- Projected Total Depth 4100 feet Formation Lansing

If OWWO: old well info as follows: Operator Well Name Comp Date Old Total Depth

I certify that well will comply with K.S.A. 55-101, et seq., plus eventually plugging hole to KCC specifications. Date 1-2-87 Signature of Operator or Agent WILSON RAINS Title PRESIDENT

For KCC Use: Conductor Pipe Required feet; Minimum Surface Pipe Required 200 feet per Alt. 4(2) This Authorization Expires 7-5-87 Approved By 1-5-87


Handwritten signature and initials at bottom right.

Must be filed with the K.C.C. five (5) days prior to commencing well
This card void if drilling not started within six (6) months of date received by K.C.C.

Important procedures to follow:

1. Notify District office before setting surface casing.
2. Set surface casing by circulating cement to the top.
3. File completion forms ACO-1 with K.C.C. within 90 days of well completion, following instructions on ACO-1, side 1, and including copies of wireline logs.
4. Notify District office 48 hours prior to old well workover or re-entry.
5. Prior to filing Intent, prepare a proposed plugging plan in case well is D & A, then obtain approval of plan when calling district office prior to setting surface pipe.
6. Submit plugging report (CP-4) to K.C.C. after plugging is completed.
7. Obtain an approved injection docket number before disposing of salt water.
8. Notify K.C.C. within 10 days when injection commences or terminates.

A Regular Section of Land 1 Mile = 5,280 Ft.

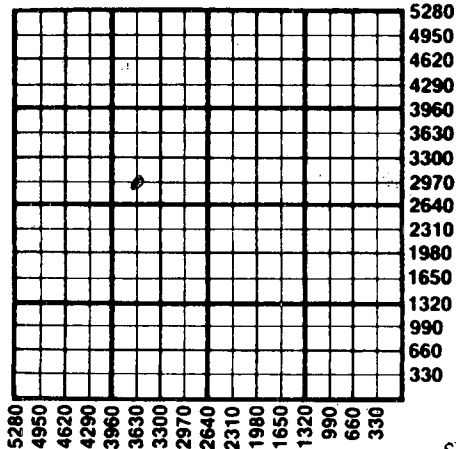

RECEIVED
STATE CORPORATION COMMISSION

JAN 5 1987

CONSERVATION DIVISION
Wichita, Kansas

01-05-1987

State Corporation Commission of Kansas
Conservation Division
200 Colorado Derby Building
Wichita, Kansas 67202
(316) 263-3238