

OWWO

For KCC Use: 2-25-03
Effective Date: 4
District # 4
SGA? Yes No

KANSAS CORPORATION COMMISSION
OIL & GAS CONSERVATION DIVISION
NOTICE OF INTENT TO DRILL

Form C-1
September 1999
Form must be Typed
Form must be Signed
All blanks must be Filled

Must be approved by KCC five (5) days prior to commencing well

Expected Spud Date 02 24 03
month day year

OPERATOR: License# 31866
Name: RL Investment
Address: 217 Saint Peter St.
City/State/Zip: Morland, KS 67650
Contact Person: Leon Pfeifer
Phone: 785-627-5711

CONTRACTOR: License# 32579
Name: Pfeifer DOZER service LLC

Well Drilled For: Oil Gas OWWO Seismic; # of Holes Other
Well Class: Enh Rec Storage Disposal Infield Pool Ext. Wildcat Other
Type Equipment: Mud Rotary Air Rotary Cable

If OWWO: old well information as follows:
Operator: Sharon Resources
Well Name: Popp #1
Original Completion Date: 01-30-85 Original Total Depth: 4157

Directional, Deviated or Horizontal wellbore? Yes No
If Yes, true vertical depth: _____
Bottom Hole Location: _____
KCC DKT #: _____

Spot East West
NE NW NW 1/4 Sec. 15 Twp. 09 S. R. 27
4940 feet from S / W (circle one) Line of Section
4210 feet from E / W (circle one) Line of Section
Is SECTION Regular Irregular?

(Note: Locate well on the Section Plat on reverse side)
County: Sheridan
Lease Name: Popp Well #: 1
Field Name: McFadden South
Is this a Prorated / Spaced Field? Yes No
Target Information(s): LKC
Nearest Lease or unit boundary: 340'
Ground Surface Elevation: 2710 feet MSL
Water well within one-quarter mile: Yes No
Public water supply well within one mile: Yes No
Depth to bottom of fresh water: 500 250
Depth to bottom of usable water: 1200 1520
Surface Pipe by Alternate: N/A 1 2
Length of Surface Pipe Planned to be set: N/A 344
Length of Conductor Pipe required: N/A NONE
Projected Total Depth: 4100
Producing Formation Target: LKC
Water Source for Drilling Operations: Well _____ Farm Pond _____ Other XX
DWR Permit #: _____
(Note: Apply for Permit with DWR)
Will Cores be taken? Yes No
If Yes, proposed zone: _____

AFFIDAVIT

The undersigned hereby affirms that the drilling, completion and eventual plugging of this well will comply with K.S.A. 55-101, et. seq.
It is agreed that the following minimum requirements will be met:

1. Notify the appropriate district office **prior** to spudding of well;
2. A copy of the approved notice of intent to drill **shall be** posted on each drilling rig;
3. The minimum amount of surface pipe as specified below **shall be set** by circulating cement to the top; in all cases surface pipe **shall be set** through all unconsolidated materials plus a minimum of 20 feet into the underlying formation.
4. If the well is dry hole, an agreement between the operator and the district office on plug length and placement is necessary **prior to plugging**;
5. The appropriate district office will be notified before well is either plugged or production casing is cemented in;
6. If an ALTERNATE II COMPLETION, production pipe shall be cemented from below any usable water to surface within **120 days** of spud date. **In all cases, NOTIFY district office** prior to any cementing.

I hereby certify that the statements made herein are true and to the best of my knowledge and belief.

Date: 02-18-03 Signature of Operator or Agent: Leon Pfeifer Title: Partner

For KCC Use ONLY
API # 15 - 179-20795-00-01
Conductor pipe required NONE feet
Minimum surface pipe required 344 feet per Alt. ②
Approved by: RSP 2-20-03
This authorization expires: 8-20-03
(This authorization void if drilling not started within 6 months of effective date.)
Spud date: _____ Agent: _____

- Remember to:
- File Drill Pit Application (form CDP-1) with Intent to Drill;
 - File Completion Form ACO-1 within 120 days of spud date;
 - File acreage attribution plat according to field proration orders;
 - Notify appropriate district office 48 hours prior to workover or re-entry;
 - Submit plugging report (CP-4) after plugging is completed;
 - Obtain written approval before disposing or injecting salt water.

RECEIVED
FEB 20 2003
KCC WICHITA

15
9
2-17

IN ALL CASES PLOT THE INTENDED WELL ON THE PLAT BELOW

Plat of acreage attributable to a well in a prorated or spaced field

If the intended well is in a prorated or spaced field, please fully complete this side of the form. If the intended well is in a prorated or spaced field complete the plat below showing that the well will be properly located in relationship to other wells producing from the common source of supply. Please show all the wells and within 1 mile of the boundaries of the proposed acreage attribution unit for gas wells and within 1/2 mile of the boundaries of the proposed acreage attribution unit for oil wells.

API No: 15 - 179 - 120, 795
 Operator: RL Investment
 Lease: Popp
 Well Number: 1
 Field: McFadden South
 Number of Acres attributable to well: 10
 QTR / QTR / QTR of acreage: - NW - NW

Location of Well: County: Sheridan
4940 feet from S / N (circle one) Line of Section
4210 feet from E / W (circle one) Line of Section
 Sec. 15 Twp. 09 S. R. 27 East West



Is Section XX Regular or Irregular

If Section is Irregular, locate well from nearest corner boundary.

Section corner used: NE NW SE SW

PLAT

(Show location of the well and shade attributable acreage for prorated or spaced wells.)
(Show footage to the nearest lease or unit boundary line.)

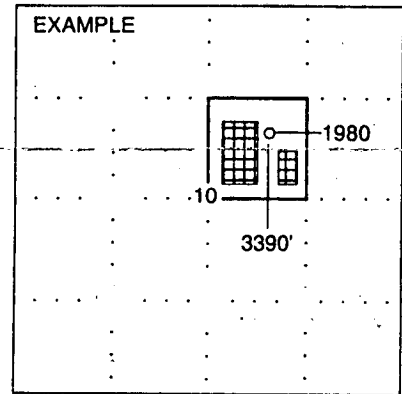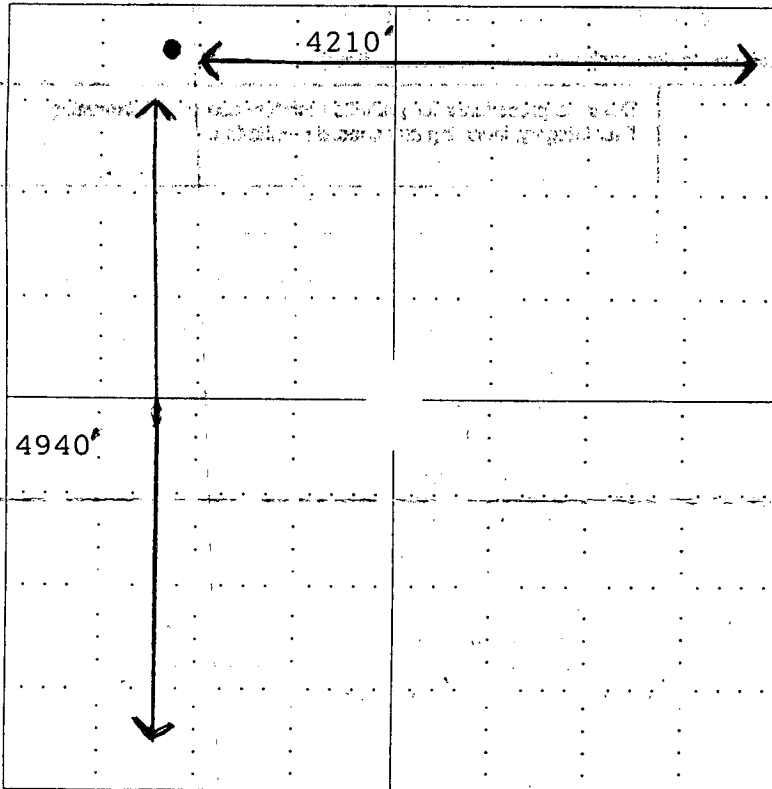

NOTE: In all cases locate the spot of the proposed drilling location.

In plotting the proposed location of the well, you must show:

1. The manner in which you are using the depicted plat by identifying section lines, i.e. 1 section, 1 section with 8 surrounding sections, 4 sections, etc.
2. The distance of the proposed drilling location from the section's south / north and east / west.
3. The distance to the nearest lease or unit boundary line.
4. If proposed location is located within a prorated or spaced field a certificate of acreage attribution plat must be attached: (CO-7 for oil wells; CG-8 for gas wells).