

4 EFFECTIVE DATE: 3-9-91

FORM MUST BE TYPED  
FORM C-1 4/90

State of Kansas

FORM MUST BE SIGNED  
ALL BLANKS MUST BE FILLED

NOTICE OF INTENTION TO DRILL

Must be approved by the K.C.C. five (5) days prior to commencing well

Expected Spud Date: 03/04/91  
month day year

C NW Sec 10 Twp 09 S Rg 23 East West

OPERATOR: License # 3007

3960 feet from South Line of Section  
3960 feet from East Line of Section  
(Note: Locate well on Section Plat on Reverse Side)

Name: WESTERN KANSAS EXPLORATION  
Address: P.O. BOX 126  
City/State/Zip: HAYS KS 67601  
Contact Person: STAN YOUNGER  
Phone: (913) 628-2296

County: GRAHAM  
Lease Name: QUINT Well# #1  
Field Name:

CONTRACTOR: License # 4083  
Name: WESTERN KANSAS DRILLING

Is this a Prorated Field? yes XX no  
Target Formation(s): LANSING / KC  
Nearest lease or unit boundary: 1320

Well Drilled For: Well Class: Type Equipment:  
XX Oil Inj XX Infield XX Mud Rotary  
Gas Storage Pool Ext Air Rotary  
OWWO Disposal Wildcat Cable  
Seismic; # of Holes

Ground Surface Elevation: N/A feet MSL  
Domestic well within 330 feet: yes XX no  
Municipal well within one mile: yes XX no  
Depth to bottom of fresh water: 100  
Depth to bottom of usable water: 1400  
Surface Pipe by Alternate: 1 XX 2  
Length of Surface Pipe Planned to be set: 200  
Length of Conductor Pipe required: \*\*\*\*\*  
Projected Total Depth: 4000  
Formation at Total Depth: LANSING / KC

If OWWO; old well information as follows:  
Operator:  
Well Name:  
Comp Date: Old Total Depth:

Water Source for Drilling Operations:  
well farm pond XX other  
DWR Permit#:  
Will Cores Be Taken? yes XX no

Directional, Deviated or Horizontal Wellbore? yes XX no  
If yes, total depth location:

If yes, proposed zone:

AFFIDAVIT

The undersigned hereby affirms that the drilling, completion and eventual plugging of this well will comply with K.S.A. 55-101, et. seq.

It is agreed that the following minimum requirements will be met:

- 1. The appropriate district office shall be notified before setting surface pipe;
- 2. The minimum amount of surface pipe as specified above shall be set by circulating cement to the top; in all cases surface pipe shall be set through all unconsolidated materials plus a minimum of 20 feet into the underlying formation;
- 3. If the well is dry, a plugging proposal shall be submitted to the district office. An agreement between the operator and the district office on plug length and placement is necessary prior to plugging;
- 4. The appropriate district office will be notified before well is either plugged or production casing is cemented in;
- 5. If an Alternate II completion, production pipe shall be cemented from below any usable water to surface within 120 days of spud date. In all cases, notify district office prior to any cementing.

I hereby certify that the statements made herein are true and to the best of my knowledge and belief.

Date: 03/04/91 Signature of Operator or Agent:

Signature: [Handwritten Signature] Title: AS AGENT  
SEARCH, INC.

WAL  
K  
N

FOR KCC USE:  
API # 15- 065-22,624-00-00  
Conductor Pipe Required None feet  
Minimum surface pipe required 200 feet per Alt. 2  
Approved by: [Signature] 3-4-91  
EFFECTIVE DATE: 3-9-91  
This authorization expires: 9-4-91  
(This authorization void if drilling not started within 6 months of effective date.)  
Spud date: Agent:

CONSERVATION DIVISION  
Wichita, Kansas

MAR 4 1991

102999

REMEMBER TO:

- File Drill Pit Application (form CDP-1) with Intent to Drill;
- File Completion Form ACO-1 within 120 days of spud date;
- File acreage attribution plat according to field proration orders;
- Notify appropriate district office 48 hours prior to workover or re-entry;
- Submit plugging report (CP-4) after plugging is completed;
- Obtain written approval before disposing or injecting salt water.

PLAT OF ACREAGE ATTRIBUTABLE TO A WELL


State Corporation Commission, Conservation Division  
200 Colorado Derby Bldg. Wichita, Kansas 67202

OPERATOR WESTERN KANSAS EXPLORATION LOCATION OF WELL:  
 LEASE QUINT 3960 feet north of SE corner  
 WELL NUMBER #1 3960 feet west of SE corner  
 FIELD \_\_\_\_\_ NW Sec. 10 T 09 R 23 NW  
 COUNTY GRAHAM  
 NO. OF ACRES ATTRIBUTABLE TO WELL \_\_\_\_\_ IS SECTION REGULAR IRREGULAR?  
 DESCRIPTION OF ACREAGE NW IF IRREGULAR, LOCATE WELL FROM NEAREST  
 CORNER BOUNDARY.

NOTE: If plat depicted is insufficient for your circumstances, you may attach your own scaled or surveyed plat.

\*non-prorated field

PLAT

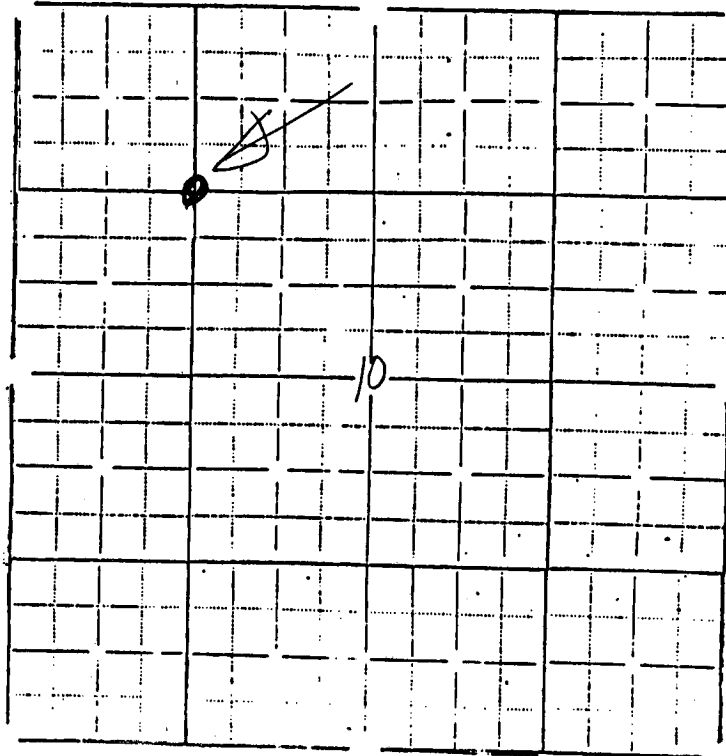

In plotting the proposed location of the well, you must show:

- 1) The manner in which you are using the depicted plat by identifying section lines, i.e.: Section, section with 8 surrounding partial sections, 4 sections, 16 sections, etc.;
- 2) the well's location relative to the location of other wells producing from the same common source of supply in adjoining drilling units, pursuant to K.A.R. 82-3-108, 82-3-207, 82-3-312, or special orders of the Commission;
- 3) the distance of the proposed drilling location from the section's east and south lines; and
- 4) the distance to the nearest lease or unit boundary line.

I hereby certify that the statements made herein are true and to the best of my knowledge and belief.

Signature of Operator or Agent \_\_\_\_\_  
 Date 03/04/91 Title SEARCH, INC.