

CARD MUST BE TYPED

State of Kansas

CARD MUST BE SIGNED

NOTICE OF INTENTION TO DRILL

(see rules on reverse side)

Expected Spud Date... December, 30 1988
month day year

API Number 15— 065-01,023-00-02 ✓

OPERATOR: License # 03955

SE. SE. SW. Sec. 31... Twp. 9... S, Rg. 21 X East
330 West

Name K Y Oil company

Ft. from South Line of Section

Address R.R. 1 Box 25

2970 Ft. from East Line of Section

City/State/Zip Palco, Kansas 67657

(Note: Locate well on Section Plat on reverse side)

Contact Person Brett L. Yelton

Nearest lease or unit boundary line 330 feet

Phone 913-737-4166 or 4085

County Graham

CONTRACTOR: License # 8132

Lease Name Gustafson Well # 1

Name Leon's Drilling H & H Oil Co

Ground surface elevation 2298 feet MSL

City/State Plainville, Kansas

Well Drilled For: Well Class: Type Equipment:

Domestic well within 330 feet: —yes X no

X Oil — Storage — Infield — Mud Rotary

Municipal well within one mile: —yes X no

— Gas — Inj X Pool Ext. — Air Rotary

Depth to bottom of fresh water 100'

X OWWO — Expl — Wildcat X Cable

Depth to bottom of usable water 1450

If OWWO: old well info as follows:

Surface pipe by Alternate: 1 2 X

Operator D. L. Heller Drilling Co.

Surface pipe ~~plumb line~~ set 121' 8" Already set

Well Name #1-3 Gustafson "OWWO"

Conductor pipe required

Comp Date 5/5/79 Old Total Depth 3871'

Projected Total Depth 3870 feet

I certify that well will comply with K.S.A. 55-101, et seq., plus eventually plugging hole to KCC specifications.

Formation Arbuckle

Date 12/22/88 Signature of Operator or Agent Title President

For KCC Use:

Conductor Pipe Required feet; Minimum Surface Pipe Required 121 feet per Alt. X (2)

This Authorization Expires 12-29-88 Approved By LKM 12-29-88

EFFECTIVE DATE: 1-3-88


Must be filed with the K.C.C. five (5) days prior to commencing well
This card void if drilling not started within six (6) months of date received by K.C.C.

Important procedures to follow:

1. Notify District office before setting surface casing.
2. Set surface casing by circulating cement to the top.
3. File completion forms ACO-1 with K.C.C. within 120 days of well spud date, following instructions on ACO-1, side 1, and including copies of wireline logs.
4. Notify District office 48 hours prior to old well workover or re-entry.
5. Prior to filing Intent, prepare a proposed plugging plan in case well is D & A, then obtain approval of plan when calling district office prior to setting surface pipe.
6. Submit plugging report (CP-4) to K.C.C. after plugging is completed.
7. Obtain an approved injection docket number before disposing of salt water.
8. Notify K.C.C. within 10 days when injection commences or terminates.

If an alternate 2 completion, cement in the production pipe from below any usable water to surface within 120 days of spud date.

A Regular Section of Land
1 Mile = 5,280 Ft.

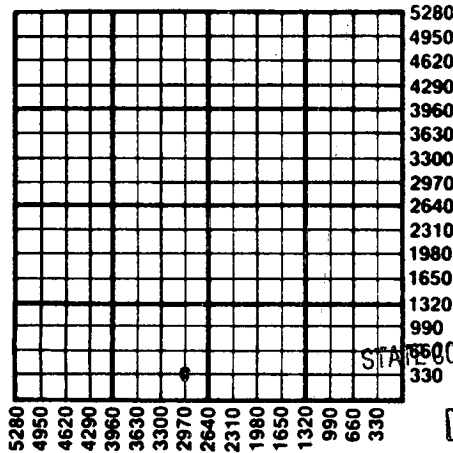

RECEIVED
STATE CORPORATION COMMISSION

DEC 20 1988

12-29-88
CONSERVATION DIVISION
Wichita, Kansas

State Corporation Commission of Kansas
Conservation Division
200 Colorado Derby Building
Wichita, Kansas 67202-1212
(316) 263-3238