

CARD MUST BE TYPED

State of Kansas

CARD MUST BE SIGNED

# NOTICE OF INTENTION TO DRILL

(see rules on reverse side)

Starting Date May 15, 1987  
month day year

API Number 15- 065-22,372-00-00

OPERATOR: License # 5068  
Name Black Petroleum Company  
Address 527 Union Center Bldg  
City/State/Zip Wichita, Kansas 67202  
Contact Person Thomas E. Black  
Phone 316-264-9342

~~East~~  
S/2 SW SE Sec. 15 Twp. 9 S, Rg. 22 X West  
330 Ft. from South Line of Section  
1980 Ft. from East Line of Section

(Note: Locate well on Section Plat on reverse side)

CONTRACTOR: License #  
Name  
City/State

Nearest lease or unit boundary line 330 feet  
County Graham

Well Drilled For: Well Class: Type Equipment:  
 Oil  SWD  Infield  Mud Rotary  
 Gas  Inj  Pool Ext.  Air Rotary  
 OWWO  Expl  Wildcat  Cable

Lease Name BROWN Well # 1

Ground surface elevation \_\_\_\_\_ feet MSL

Domestic well within 330 feet:  yes  no

Municipal well within one mile:  yes  no

Depth to bottom of fresh water ~200

Depth to bottom of usable water 1100

Surface pipe by Alternate: 1 2

Surface pipe planned to be set 250'

Conductor pipe required \_\_\_\_\_

Projected Total Depth 3900 feet

Formation Base Kansas City

If OWWO: old well info as follows:

Operator  
Well Name  
Comp Date Old Total Depth

I certify that well will comply with K.S.A. 55-101, et seq., plus eventually plugging hole to KCC specifications.

Date May 7, 1987 Signature of Operator or Agent Thomas E. Black Title OWNER

For KCC Use:

Conductor Pipe Required \_\_\_\_\_ feet; Minimum Surface Pipe Required 225 feet per Alt. 2

This Authorization Expires 11-7-87 Approved By 5-7-87


*Pat [Signature]*

Must be filed with the K.C.C. five (5) days prior to commencing well  
This card void if drilling not started within six (6) months of date received by K.C.C.

### Important procedures to follow:

1. Notify District office before setting surface casing.
2. Set surface casing by circulating cement to the top.
3. File completion forms ACO-1 with K.C.C. within 90 days of well completion, following instructions on ACO-1, side 1, and including copies of wireline logs.
4. Notify District office 48 hours prior to old well workover or re-entry.
5. Prior to filing Intent, prepare a proposed plugging plan in case well is D & A, then obtain approval of plan when calling district office prior to setting surface pipe.
6. Submit plugging report (CP-4) to K.C.C. after plugging is completed.
7. Obtain an approved injection docket number before disposing of salt water.
8. Notify K.C.C. within 10 days when injection commences or terminates.

### A Regular Section of Land 1 Mile = 5,280 Ft.

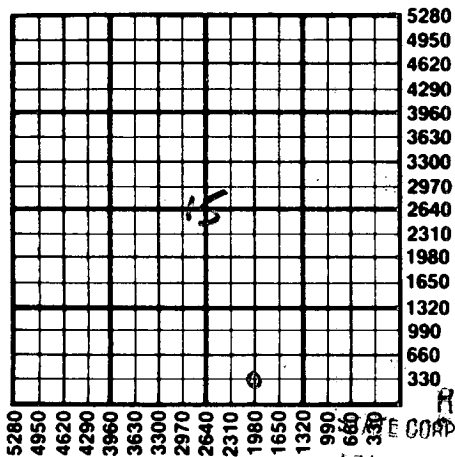

RECEIVED  
CORPORATION COMMISSION  
MAY 7 1987  
CONSERVATION DIVISION  
Wichita, Kansas

in alternate 2 completion, cement in the production pipe from below any usable water to surface within 120 days of spud date.

State Corporation Commission of Kansas  
Conservation Division  
200 Colorado Derby Building  
Wichita, Kansas 67202  
(316) 263-3238

5-7-87