

CARD MUST BE TYPED

State of Kansas

CARD MUST BE SIGNED ✓

NOTICE OF INTENTION TO DRILL

(see rules on reverse side)

Starting Date May 5, 1987 month day year

API Number 15- 179-20,893-00-00

OPERATOR: License # 5068

SE SE SE Sec. 1 Twp. 9 S, Rg. 27 West

Name Black Petroleum Company

330' Ft. from South Line of Section

Address 527 Union Center Bldg.

330' Ft. from East Line of Section

City/State/Zip Wichita, Kansas 67202

(Note: Locate well on Section Plat on reverse side)

Contact Person Thomas E. Black

Nearest lease or unit boundary line 330' feet

Phone 316-264-9342

County SHERIDAN

CONTRACTOR: License # 5418

Lease Name POPP Well # 1

Name Allen Drilling Company

Ground surface elevation feet MSL

City/State Great Bend, Kansas

Domestic well within 330 feet: yes X no

Well Drilled For: Well Class: Type Equipment:

Municipal well within one mile: yes X no

X Oil SWD Infield X Mud Rotary

Depth to bottom of fresh water 150'

Gas Inj Pool Ext Air Rotary

Depth to bottom of usable water 1400'

OWWO Expl Wildcat Cable

Surface pipe by Alternate: 1 2 X

If OWWO: old well info as follows:

Surface pipe planned to be set 250'

Operator

Conductor pipe required

Well Name

Projected Total Depth 4100' feet

Comp Date Old Total Depth

Formation Base Kansas City

I certify that well will comply with K.S.A. 55-101, et seq., plus eventually plugging hole to KCC specifications.

Date April 29, 87 Signature of Operator or Agent Thomas E. Black Title OWNER

For KCC Use:

Conductor Pipe Required feet; Minimum Surface Pipe Required 225 feet per Alt. 4 (2)

This Authorization Expires 10-29-87 Approved By 4-29-87


Handwritten signature

Must be filed with the K.C.C. five (5) days prior to commencing well
This card void if drilling not started within six (6) months of date received by K.C.C.

Important procedures to follow:

1. Notify District office before setting surface casing.
2. Set surface casing by circulating cement to the top.
3. File completion forms ACO-1 with K.C.C. within 90 days of well completion, following instructions on ACO-1, side 1, and including copies of wireline logs.
4. Notify District office 48 hours prior to old well workover or re-entry.
5. Prior to filing Intent, prepare a proposed plugging plan in case well is D & A, then obtain approval of plan when calling district office prior to setting surface pipe.
6. Submit plugging report (CP-4) to K.C.C. after plugging is completed.
7. Obtain an approved injection docket number before disposing of salt water.
8. Notify K.C.C. within 10 days when injection commences or terminates.

A Regular Section of Land
1 Mile = 5,280 Ft.

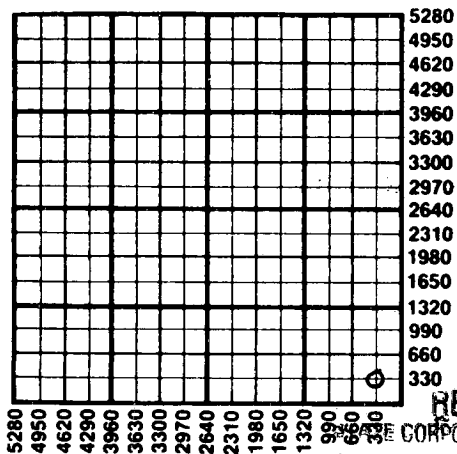

RECEIVED

CORPORATION COMMISSION

APR 29 1987
04-29-1987
CONSERVATION DIVISION
Wichita, Kansas

an alternate 2 completion, cement in the production pipe from below any usable water to surface within 120 days of spud date.

State Corporation Commission of Kansas
Conservation Division
200 Colorado Derby Building
Wichita, Kansas 67202
(316) 263-3238