

CARD MUST BE TYPED *CORRECTED NOTICE OF INTENTION TO DRILL

State of Kansas
(see rules on reverse side)

CARD MUST BE SIGNED
CORRECTED
3-26-85

Starting Date: 03 27 85
month day year

API Number 15- 179-20,805-00-00

OPERATOR: License # 9883

SW SE SW Sec 10 Twp 9 S, Rge 27
(location) East West

Name Sharon Resources, Inc.
Address 7100 E. Belleview, St., 201
City/State/Zip Englewood, CO 80111
Contact Person Charles Davis
Phone 303-595-9111

* 330 Ft North from Southeast Corner of Section
* 3630 Ft West from Southeast Corner of Section
(Note: Locate well on Section Plat on reverse side)

CONTRACTOR: License # 6033

Nearest lease or unit boundary line *330 feet.

Name Murfin Drilling Company
City/State Wichita, KS

County Sheridan

Lease Name White Well# 2

Well Drilled For: Well Class: Type Equipment:

- Oil Swd Infield Mud Rotary
- Gas Inj Pool Ext. Air Rotary
- OWWO Expl Wildcat Cable

Domestic well within 330 feet: yes no
Municipal well within one mile: yes no

If OWWO: old well info as follows:

Depth to Bottom of fresh water 200 feet
Lowest usable water formation Dakota
Depth to Bottom of usable water 1425 feet
Surface pipe by Alternate: 1 2
Surface pipe to be set 300 feet
Conductor pipe if any required N/A feet
Ground surface elevation 2663 feet MSL
This Authorization Expires 9-25-85
Approved By 3-25-85

Operator
Well Name
Comp Date Old Total Depth
Projected Total Depth 4120 feet
Projected Formation at TD BKC
Expected Producing Formations LKC

I certify that we will comply with K.S.A. 55-101, et seq., plus eventually plugging hole to K.C.C. specifications.

* was. 410 FSL 3530 FSL

Date 3-26-85 Signature of Operator or Agent


J. Goss
Jack E. Goss, Agent for Operator Title Ass't. Drilling Manager

Must be filed with the K.C.C. five (5) days prior to commencing well
This card void if drilling not started within six (6) months of date received by K.C.C.

RECEIVED
STATE CORPORATION COMMISSION
03-26-1985
MAR 26 1985

A Regular Section of Land

1 Mile = 5,280 FT
CONSERVATION DIVISION
Wichita, Kansas

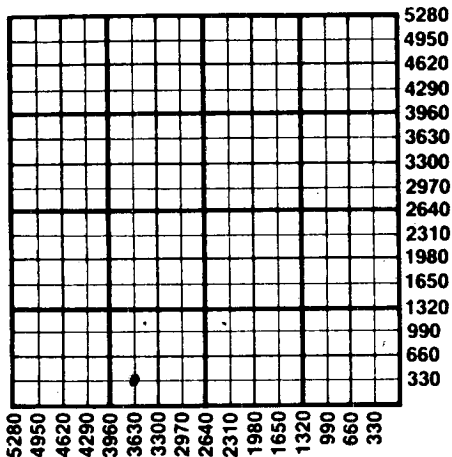

Important procedures to follow:

1. Notify District office before setting surface casing.
2. Set surface casing by circulating cement to the top.
3. File completion forms ACO-1 with K.C.C. within 90 days of well completion, following instructions on ACO-1, side 1, and including copies of wireline logs.
4. Notify District office 48 hours prior to old well workover or re-entry.
5. Prior to plugging, prepare a plugging plan, then obtain agreement from the appropriate district office for an approved plugging plan.
6. Submit plugging report (CP-4) to K.C.C. after plugging is completed.
7. Obtain an approved injection docket number before disposing of salt water.
8. Notify K.C.C. within 10 days when injection commences or terminates.
9. If an alternate 2 completion, cement in the production pipe from below any usable water to surface within 120 days of spud date.

State Corporation Commission of Kansas
Conservation Division
200 Colorado Derby Building
Wichita, Kansas 67202
(316) 263-3238