

CARD MUST BE TYPED

State of Kansas
NOTICE OF INTENTION TO DRILL

CARD MUST BE SIGNED

(see rules on reverse side)

Starting Date: 9 12 85
month day year

API Number 15- 179-20,841-00-00

OPERATOR: License # 5011
Name Viking Resources
Address 217 E. William
City/State/Zip Wichita, KS 67202-4005
Contact Person Jim Devlin
Phone 316-262-2502

C. E $\frac{1}{2}$ E $\frac{1}{2}$ NE. Sec .12. Twp .9. S, Rge .27. East
(location) West

CONTRACTOR: License # 5420
Name White and Ellis Drilling, Inc.
City/State Wichita, KS 67202-3484

.3960..... Ft North from Southeast Corner of Section
.330..... Ft West from Southeast Corner of Section
(Note: Locate well on Section Plat on reverse side)

Well Drilled For: Well Class: Type Equipment:
 Oil Swd Infield Mud Rotary
 Gas Inj Pool Ext. Air Rotary
 OWWO Expl Wildcat Cable

Nearest lease or unit boundary line 330 feet.
County ... Sheridan
Lease Name ... Mickey Well# 1

Domestic well within 330 feet : yes no
Municipal well within one mile : yes no

If OWWO: old well info as follows:
Operator
Well Name
Comp Date Old Total Depth
Projected Total Depth 4100 feet
Projected Formation at TD BKC
Expected Producing Formations LKC

Depth to Bottom of fresh water 200 feet
Lowest usable water formation Dakota
Depth to Bottom of usable water 1400 feet
Surface pipe by Alternate : 1 2
Surface pipe to be set 250 feet
Conductor pipe if any required None feet
Ground surface elevation Unknown feet MSL
This Authorization Expires 2-1-86
Approved By 8-1-85 *R*

I certify that we will comply with K.S.A. 55-101, et seq., plus eventually plugging hole to K.C.C. specifications. Production string will be immediately cemented from below alternate 1 depth to surface.

Date 29 July 85..... Signature of Operator or Agent *James B. Devlin* Title Operator.....

Form C-1 4/84

Rec'd for KOHE


Must be filed with the K.C.C. five (5) days prior to commencing well
This card void if drilling not started within six (6) months of date received by K.C.C.

RECEIVED
STATE CORPORATION COMMISSION
Wichita, Kansas
AUG 3 0 1985



Important procedures to follow :

**A Regular Section of Land
1 Mile = 5,280 Ft.**

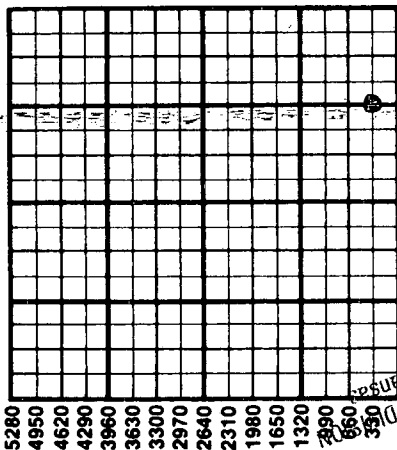

1. Notify District office before setting surface casing.
2. Set surface casing by circulating cement to the top.
3. File completion forms ACO-1 with K.C.C. within 90 days of well completion, following instructions on ACO-1, side 1, and including copies of wireline logs.
4. Notify District office 48 hours prior to old well workover or re-entry.
5. Prior to plugging, prepare a plugging plan, then obtain agreement from the appropriate district office for an approved plugging plan.
6. Submit plugging report (CP-4) to K.C.C. after plugging is completed.
7. Obtain an approved injection docket number before disposing of salt water.
8. Notify K.C.C. within 10 days when injection commences or terminates.
9. If an alternate 2 completion, cement in the production pipe from below any usable water to surface within 120 days of spud date.

08-01-1985

RECEIVED
STATE CORPORATION COMMISSION
Wichita, Kansas
AUG 1 1985

State Corporation Commission of Kansas
Conservation Division
200 Colorado Derby Building
Wichita, Kansas 67202
(316) 263-3238