

Correction

FORM MUST BE TYPED

State of Kansas

FORM MUST BE SIGNED

FORM 6-1-12/88

NOTICE OF INTENTION TO DRILL

ALL BLANKS MUST BE FILLED

EFFECTIVE DATE: 3/5/90

Must be approved by the K.C.C. five (5) days prior to commencing well

March 15

~~February 1~~, 1990

Expected Spud Date ..... month day year

10' South of  
NW.. NE.. NW. Sec .35. Twp .9... S, Rg 22.. X East  
X West

..... 4940 ..... feet from South line of Section  
..... 3630 ..... feet from East line of Section

(Note: Locate well on Section Plat Below)

\* OPERATOR: License # 30326  
Name: Howard O. Williford  
Address: RR. 1, Box 35  
City/State/Zip: Alden, KS. 67512  
Contact Person: Howard O. Williford  
Phone: (316) 278-3195

County: Graham  
Lease Name: Tremblay Well #: 1  
Field Name: Wildcat

CONTRACTOR: License #: Please Advise  
Name: unknown

Is this a Prorated Field? .... yes X ... no  
Target Formation(s): Lansing-KC, Marmaton

Well Drilled For: Well Class: Type Equipment:  
X Oil ... Inj ... Infield ... Mud Rotary  
... Gas ... Storage ... Pool Ext. ... Air Rotary  
... OAWO ... Disposal ... Wildcat ... Cable  
... Seismic; ... # of Holes

Nearest lease or unit boundary: 330'  
Ground Surface Elevation: NA ... Please Advise Feet MSL  
Domestic well within 330 feet: .... yes X ... no

Municipal well within one mile: .... yes X ... no  
Depth to bottom of fresh water: 180 100  
Depth to bottom of usable water: 1150

Surface Pipe by Alternate: .... 1 X .. 2  
Length of Surface Pipe Planned to be set: 200'  
Length of Conductor pipe required: 0

If OAWO: old well information as follows:  
Operator: .....  
Well Name: .....  
Comp. Date: ..... Old Total Depth .....

Projected Total Depth: 4,000  
Formation at Total Depth: Arbuckle  
Water Source for Drilling Operations:  
... well .... farm pond X other

Directional, Deviated or Horizontal wellbore? .... yes X .. no  
If yes, total depth location: .....

DWR Permit #: .....  
Will Cores Be Taken?: .... yes X .. no  
If yes, proposed zone: .....


\* license from Lois

**AFFIDAVIT**

The undersigned hereby affirms that the drilling, completion and eventual plugging of this well will comply with K.S.A. 55-101, et. seq.

- It is agreed that the following minimum requirements will be met:
1. The appropriate district office shall be notified before setting surface pipe;
  2. The minimum amount of surface pipe as specified above shall be set by circulating cement to the top; in all cases surface pipe shall be set through all unconsolidated materials plus a minimum of 20 feet into the underlying formation;
  3. If the well is dry, a plugging proposal shall be submitted to the district office. An agreement between the operator and the district office on plug length and placement is necessary prior to plugging;
  4. The appropriate district office will be notified before well is either plugged or production casing is cemented in;
  5. If an Alternate II completion, production pipe shall be cemented from below any usable water to surface within 120 days of spud date. In all cases, notify district office prior to any cementing.
- I hereby certify that the statements made herein are true and to the best of my knowledge and belief.

Date: 2/28/90 Signature of Operator or Agent: [Signature] Title: owner

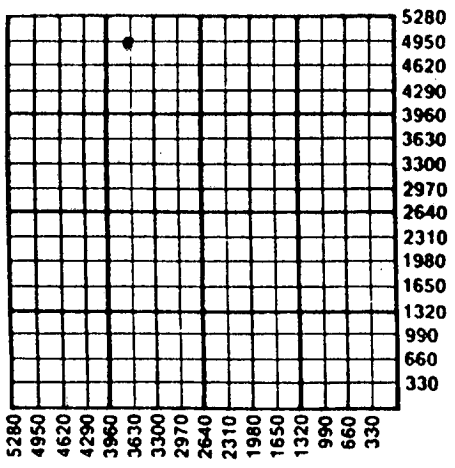

RECEIVED  
STATE COMMISSION  
2/28/90  
FEB 28 1990

FOR KCC USE: 22,558-00-00  
 API # 15- 065-23,558  
 Conductor pipe required NONE feet  
 Minimum surface pipe required 200 feet per Alt. X(2)  
 Approved by: BGA 2/28/90, BGF  
 EFFECTIVE DATE: 3/5/90  
 This authorization expires: 8/28/90 3/5/90  
 (This authorization void if drilling not started within 6 months of effective date.)  
 Spud date: \_\_\_\_\_ Agent: \_\_\_\_\_

35  
9  
22

**REMEMBER TO:**

- File Drill Pit Application (form CDP-1) with Intent to Drill;
- File Completion Form ACO-1 within 120 days of spud date;
- File acreage attribution plat according to field proration orders;
- Notify appropriate district office 48 hours prior to workover or re-entry;
- Submit plugging report (CP-4) after plugging is completed;
- Obtain written approval before disposing or injecting salt water.