


STATE OF KANSAS  
STATE CORPORATION COMMISSION

Give All Information Completely  
Make Required Affidavit  
Mail or Deliver Report to:  
Conservation Division  
State Corporation Commission  
212 North Market, Insurance Bldg.  
Wichita, Kansas

15-065-00926-00-00  
WELL PLUGGING RECORD

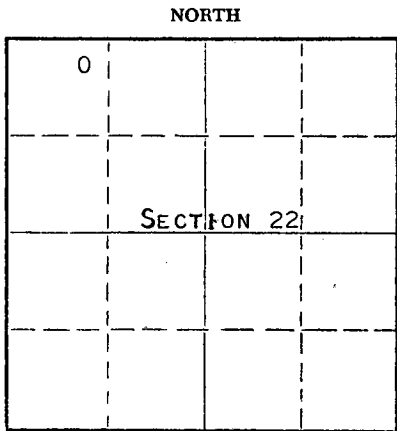

Locate well correctly on above Section Plat

GRAHAM County. Sec. 22 Twp. 9s Rge. 23W (#) (W)  
Location as "NE/CNW/SW" or footage from lines NE NW NW  
Lease Owner PETROLEUM, INC.  
Lease Name GODDARD Well No. 1  
Office Address ROUTE 2, GREAT BEND, KANSAS  
Character of Well (completed as Oil, Gas or Dry Hole) DRY HOLE  
Date well completed DECEMBER 23 19 55  
Application for plugging filed MARCH 29 19 61  
Application for plugging approved APRIL 3 19 61  
Plugging commenced APRIL 4 19 61  
Plugging completed APRIL 11 19 61  
Reason for abandonment of well or producing formation  
DEPLETION OF ALL PRODUCTIVE FORMATIONS  
If a producing well is abandoned, date of last production MARCH 10 19 61  
Was permission obtained from the Conservation Division or its agents before plugging was commenced? YES

Name of Conservation Agent who supervised plugging of this well MR. A. D. FABRICIUS  
Producing formation KANSAS CITY Depth to top 3683' Bottom 3907' Total Depth of Well 4245' Feet  
Show depth and thickness of all water, oil and gas formations.

OIL, GAS OR WATER RECORDS

CASING RECORD

FORMATION	CONTENT	FROM	TO	SIZE	PUT IN	PULLED OUT
				8-5/8"	227'	NONE
LANSING-KANSAS CITY	WATER & LITTLE OIL	3711'	3713'	5-1/2"	3860'	2439'

Describe in detail the manner in which the well was plugged, indicating where the mud fluid was placed and the method or methods used in introducing it into the hole. If cement or other plugs were used, state the character of same and depth placed, from feet to feet for each plug set.

PLUGGED BACK T.D. 3714'

PLUGGED OFF BOTTOM OF HOLE ABOVE PERFORATIONS TO 3682' WITH 4 SACKS OF CEMENT. MUDDED UP WITH HEAVY MUD TO 225' AND MADE SOLID ROCK BRIDGE, PLACED 25 SACKS CEMENT ON TO ROCK BRIDGE. MUDDED UP WITH HEAVY MUD TO 40' AND MADE SOLID ROCK BRIDGE. FILLED HOLE TO BASE OF WELL CELLAR WITH 10 SACKS OF CEMENT.

RECEIVED  
STATE CORPORATION COMMISSION  
MAY 1 1961  
CONSERVATION DIVISION  
Wichita, Kansas  
5-1-61

(If additional description is necessary, use BACK of this sheet)  
Name of Plugging Contractor MORGAN WELL PLUGGING SERVICE  
Address 102 WEST 18TH STREET, HUTCHINSON, KANSAS

STATE OF KANSAS, COUNTY OF BARTON, ss.  
DON SEARLE (employee of owner) or (owner) of the above-described well, being first duly sworn on oath, says: That I have knowledge of the facts, statements, and matters herein contained and the log of the above-described well as filed and that the same are true and correct. So help me God.

(Signature) Don Searle  
ROUTE 2, GREAT BEND, KANSAS  
(Address)

SUBSCRIBED AND SWORN TO before me this 21ST day of APRIL, 19 61

My commission expires

APRIL 14, 1963

Arthur J. Miles  
Notary Public.

# WELL LOG

15-065-00926-00-00

COMPANY Petroleum, Inc.

SEC. 22 T. 9S R. 23W

FARM GODDARD

NO. 1

LOC. NE NW NW


TOTAL DEPTH 4245'

COUNTY Graham

COMM. November 25, 1955

COMP. December 10, 1955

CONTRACTOR Garvey Drilling Company

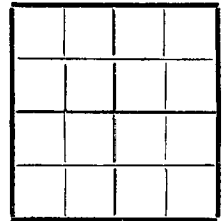

CASING 8-5/8" @ 227' w/100 sax  
5-1/2" @ 3860' w/75 sax

ELEVATION 2344' DF  
2347' RB

PRODUCTION Lansing

FIGURES INDICATE BOTTOM OF FORMATIONS

90	Clay & Sand
227	Shale
920	Shale & Shells
1195	Shale & Sand
1435	Red Bed & Shale
1470	Shale & Sand
1555	Sand
1692	Shale & Pyrite
1956	Red Bed & Shale
1995	Anhydrite
2060	Shale & Shells
2275	Shale
2625	Shale & Shells
2780	Shale & Lime
3060	Lime
3335	Lime & Shale
3387	Lime
3550	Lime & Shale
3855	Lime
3895	Lime & Shale
3910	Lime
3989	Shale & Lime
4031	Lime & Chert
4077	Shale & Chert
4128	Shale & Lime
4152	Shale & Chert
4188	Chert
4214	Lime & Chert
4245	Conglomerate & Lime

### Sample Tops

Anhydrite	1956 (+ 391)
Toronto	3667 (-1320)
Lansing	3683 (-1336) ✓
BKC	3907 (-1560)
Marmaton	4000 (-1653)
Miss.	4127 (-1780)
Simpson	4207 (-1860)
Arbuckle	4219 (-1872)

RTD 4245'

RECEIVED  
STATE CORPORATION COMMISSION

MAY 1 1961

CONSERVATION DIVISION  
Wichita, Kansas

S-1-61-30 3'

37 1/2' - 13' = 30 3'

028

KANSAS

of SEDGWICK

ss:

Karl E. Becker

of

Petroleum, Inc.

I state that the above and foregoing is a true and correct copy of the log of the GODDARD #1 well

*Karl E. Becker*

sworn to before me this 20th day of December 19 55

Expires: September 2, 1959

*Frances Sloan*  
NOTARY PUBLIC

FRANCES SLOAN, Notary Public  
My Commission expires Sept. 2, 1959