


STATE OF KANSAS
STATE CORPORATION COMMISSION

15-065-01147-00-01

WELL PLUGGING RECORD

Give All Information Completely
Make Required Affidavit
Mail or Deliver Report to
Conservation Division
State Corporation Comm.
245 North Water
Wichita, KS 67202

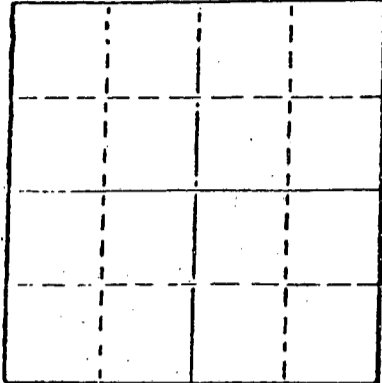

Locate well correctly on above
Section Plat

Graham County. Sec. 22 Twp. 9 Rge. 23W E/
Location as "NE/CNW 1/4 SW 1/4" or footage from lines
NE/NE/NW

Lease Owner Frontier Oil Company
Lease Name Riffel Well No. "B"-1

Office Address 1437 N. Franklin Russell, Ks. 6766
Character of Well (Completed as Oil, Gas or Dry Hole) Oil

Date Well completed _____ 19____
Application for plugging filed _____ 19____
Application for plugging approved _____ 19____
Plugging commenced April 8, 1988
Plugging completed April 14, 1988
Reason for abandonment of well or producing formation
Depleted

If a producing well is abandoned, date of last production
_____ 19____

Was permission obtained from the Conservation Division or
its agents before plugging was commenced? Yes

Name of Conservation Agent who supervised plugging of this well Gil Balthazer
Producing formation _____ Depth to top _____ Bottom _____ Total Depth of Well 3900
Show depth and thickness of all water, oil and gas formations.

OIL, GAS OR WATER RECORDS

CASING RECORD

FORMATION	CONTENT	FROM	TO	SIZE	PUT IN	PULLED OUT
				8-5/8"	209'	None
				4-1/2"	3899'	3039.78'

Describe in detail the manner in which the well was plugged, indicating where the mud fluid
was placed and the method or methods used in introducing it into the hold. If cement or other
plugs were used, state the character of same and depth placed, from _____ feet to
_____ feet for each plug set.

Dumped sand to 3600' and 4 sacks cement
Shot pipe at 3050'
Pulled pipe 73 joints of 4 1/2" casing
Squeezed well with 3 sacks hulls, 10 sacks of gel, 70 sacks 50/50 pozmix
cement with .4% added gel, 10 sacks gel and 60 sacks cement

RECEIVED
STATE CORPORATION COMMISSION

APR 21 1988

(If additional description is necessary, use BACK of this sheet)
Name of Plugging Contractor Rockhold Engineering, Inc. 4-21-81

CONSERVATION DIVISION
Wichita, Kansas

STATE OF KANSAS COUNTY OF BARTON, ss.
James W. Rockhold (employee of owner) or (owner or operator)
of the above-described well, being first duly sworn on oath, says: That I have knowledge of
the facts, statements, and matters herein contained and the log of the above-described well
as filed and that the same are true and correct. So help me God.

(Signature) James W. Rockhold
James W. Rockhold, Box 698, Great Bend,
(Address) Kansas 67530

SUBSCRIBED AND SWORN TO before me this 15th day of April, 1981

Ruth L. Sloan
Ruth L. Sloan Notary Public.

My Commission Expires _____
September 27, 1981

